ques 85.00   pd #150.00 02-03-12 MS

IREDELL COUNTY HEALTH DEPARTMENT

STATESVILLE 704-878-5305   MOORESVILLE 704-664-5281

IMPROVEMENT PERMIT / AUTHORIZATION TO CONSTRUCT / OPERATION PERMIT / EXISTING SYSTEM INSPECTION

PERMIT# 145437   PIN# 4624893114.000

OWNER OR APPLICANT CT Builders and Investments, Inc.   DATE 6/19/08

ADDRESS 19721 Bethel Church Rd. Cornelius NC 28031   PHONE: Business 704 309 9148   Home

LOCATION Brawley School Rd. TL Yacht Rd. TR Yacht Harbor TR Keel on Left   # 133 Keel Ct

SUBDIVISION Yacht Harbor   BLOCK / SECTION   LOT 24   LOT AREA ±.7acre   SITE CLASS. PS   DESIGN FLOW 480   L.T.A.R. .25

Septic Tank: 1000 Gallons; STB 312 Date 1-7-09
Pump Tank: Gallons; PT Date
Pump Make: Model Serial No.
Nitrification Field: No Fields 1 Square Feet 640' Linear Feet 320'
No Lines 4 C.F. 80' Trench Width 24" Max Trench Bottom Depth 36"

☑ New System ☐ Repair ☐ Expansion System Type: I II (III) IV V VI
System Description Gravity PPBPS
Repair System Description Exist Conv. + Grav PPBPS
Maintenance Agreement Required: ☐ Yes ☑ No
Gravel Depth N/A ☑ Gravity ☐ Pressure

☑ House/Mod. Home ☐ Mobile Home ☐ Business ☐ Other
No. Bedrooms 4   No. Persons   No. Employees

Water Supply: ☑ Individual ☐ Public ☐ Community


☐ Slab ☐ Crawl Space ☐ Basement w/plumbing ☐ Basement wo/plumbing

Comments:/Conditions: * Construction must begin on home b/f July 1 2008 or well will have to be 25' min from house by changing plans or redrilling well + abandoning Exis Well See Rule 15A NCAC 02C .0107 (a) 2-M


Comments:/Conditions: * Cut Exis lines 10' from property line use as repair * Use Flow divider and 2 D Boxes to center feed 4-80' PPBPS drainlines
Installed essentially as drawn.

1:40

INITIAL SITE SKETCH

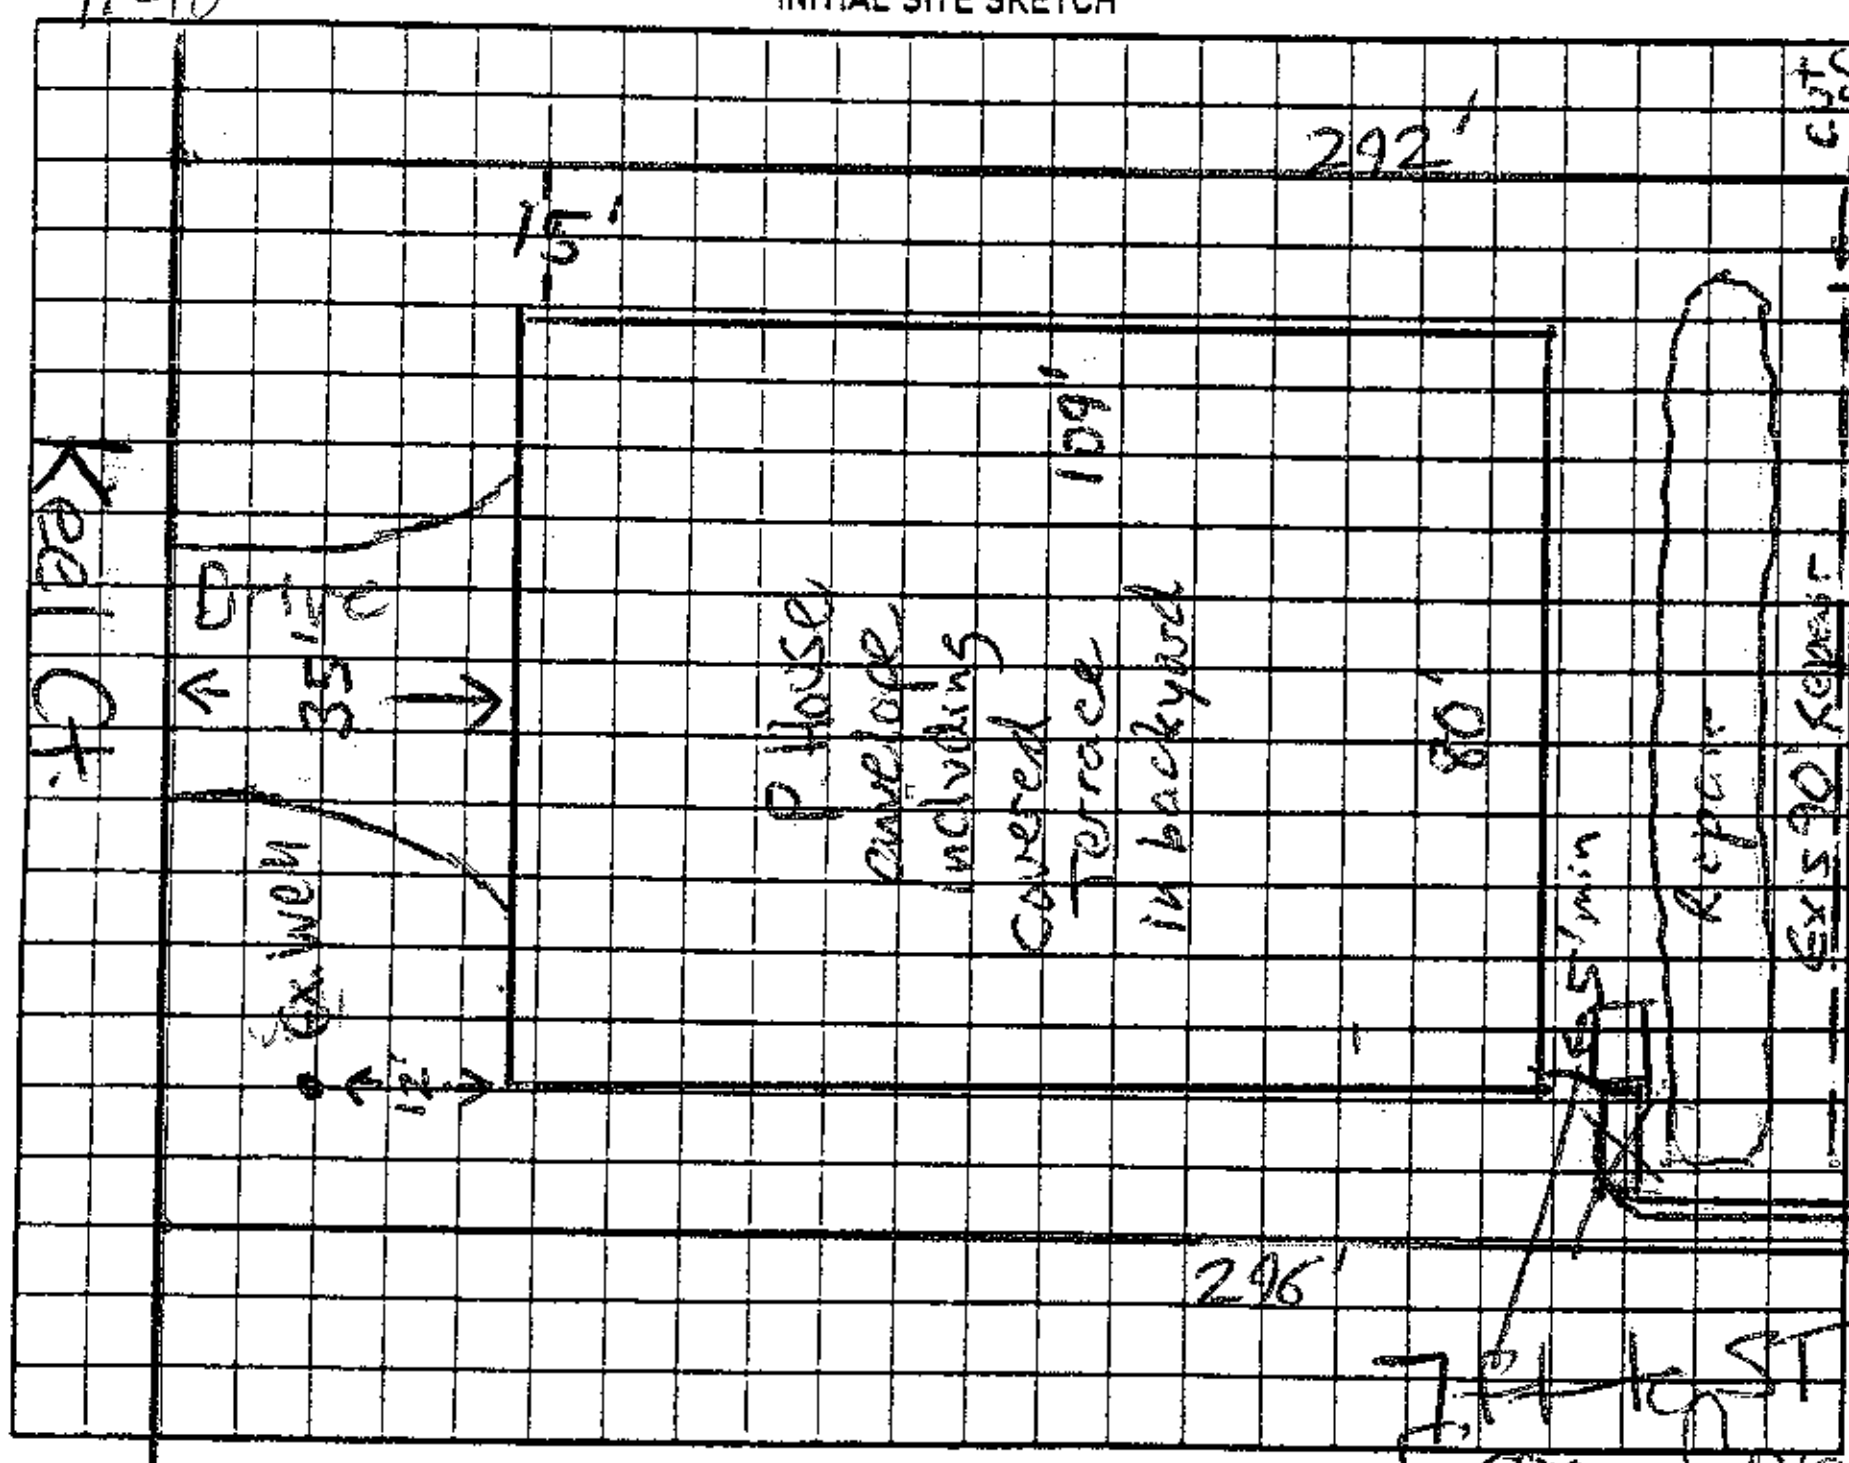

AS BUILT SKETCH

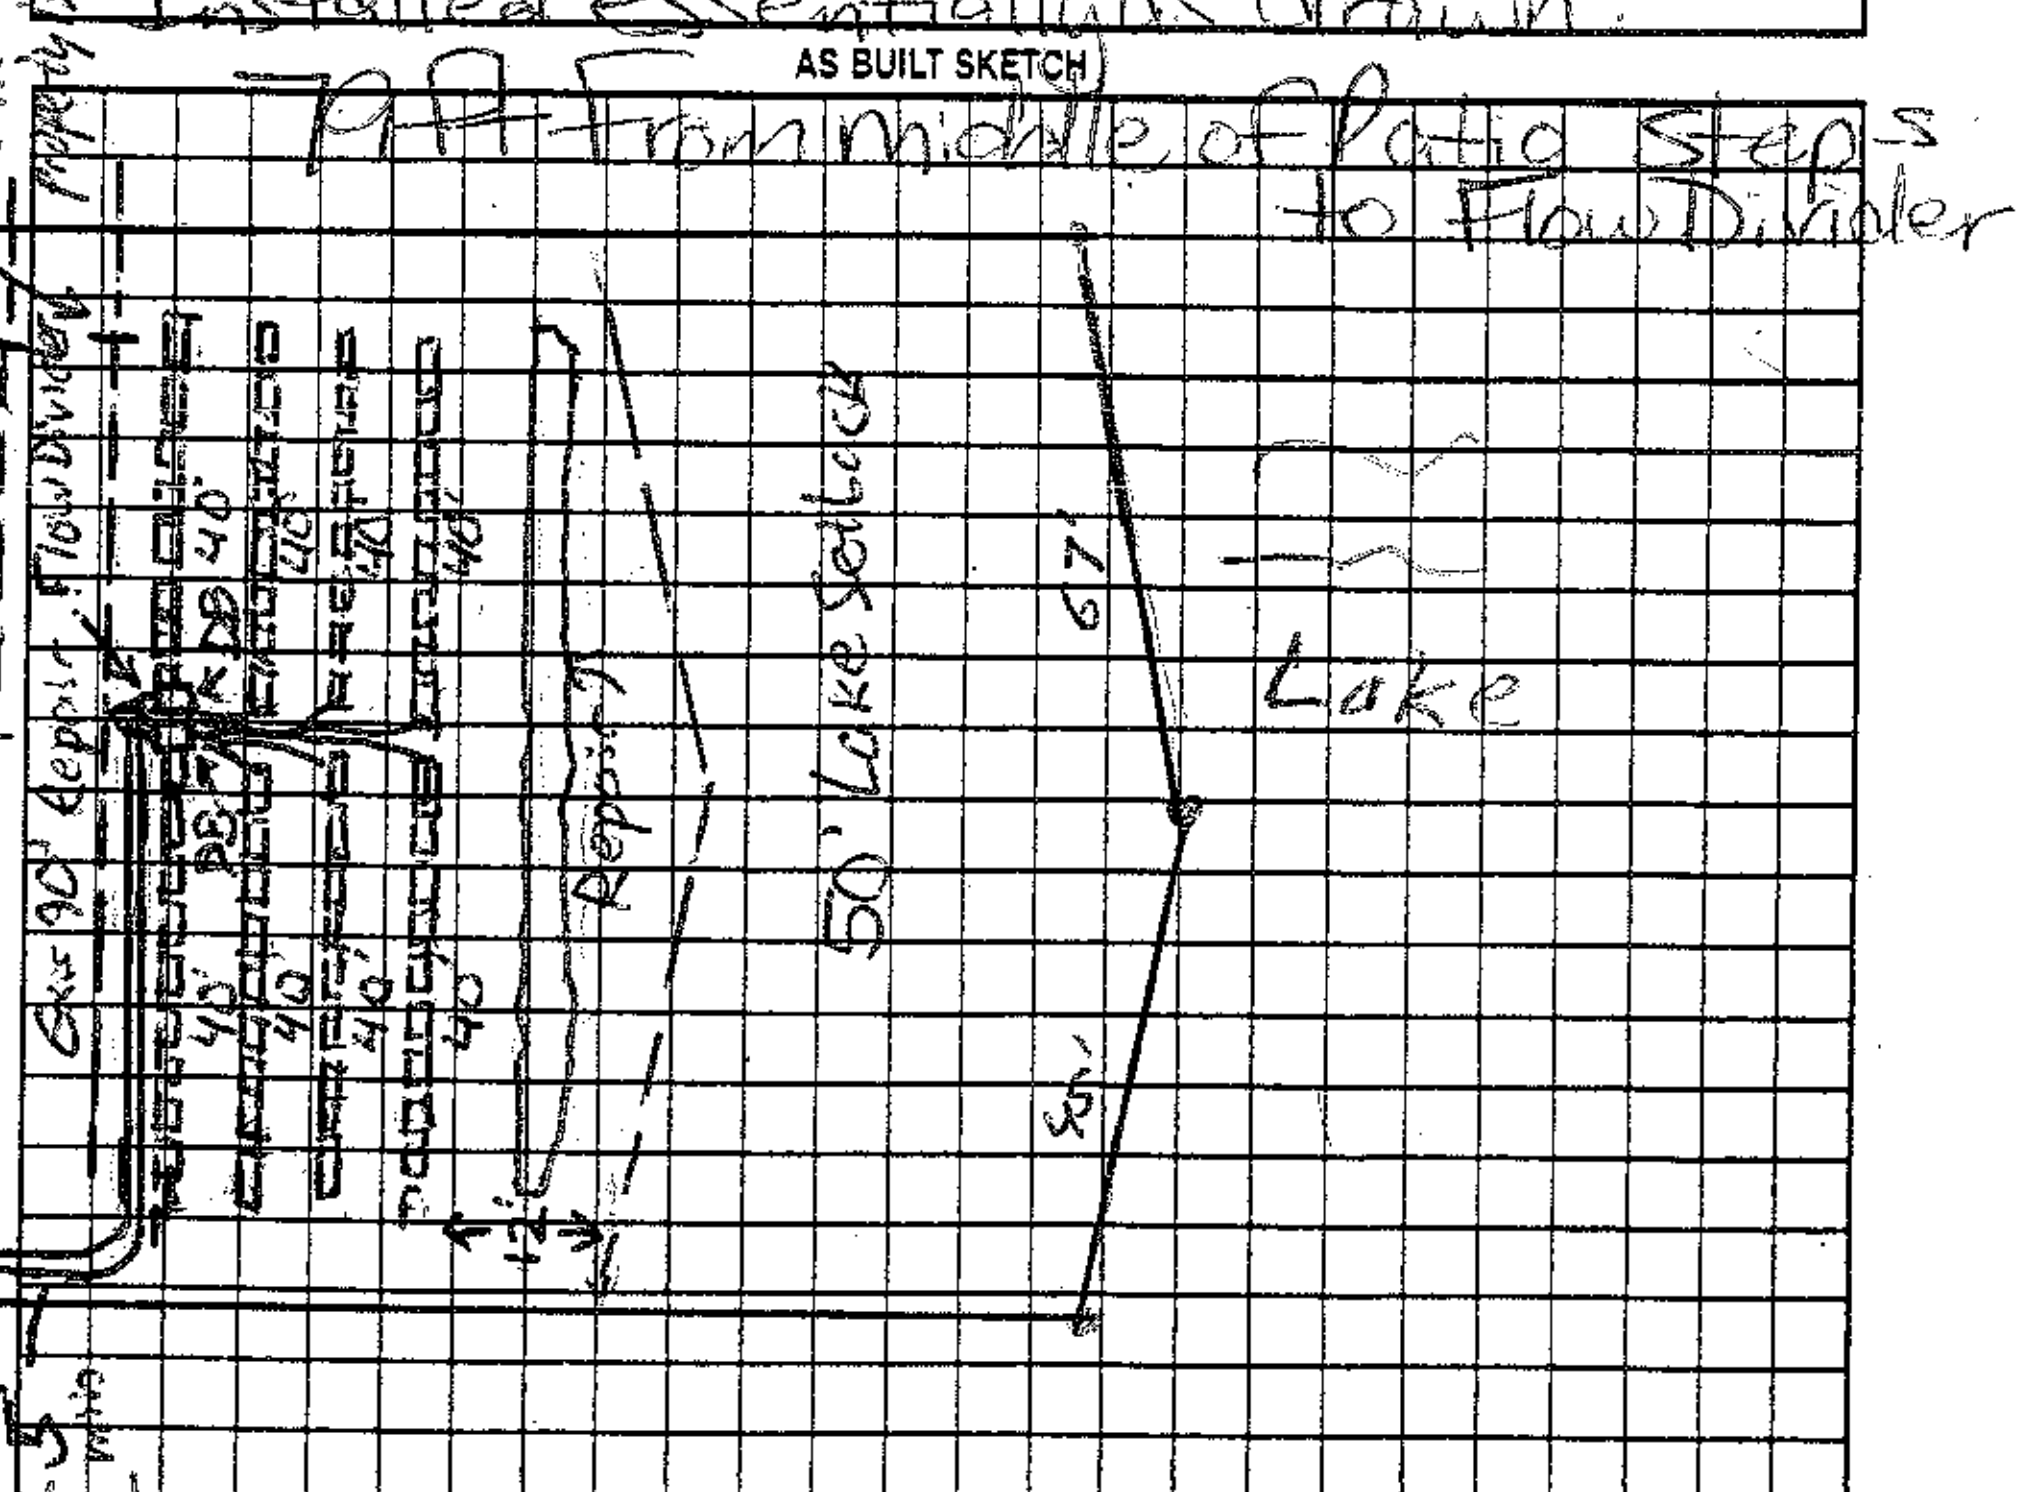

Permit can be suspended or revoked if any false information is supplied toward securing the permit/any unauthorized changes are made to the site/any unauthorized changes are made in the installation of the system. Improvement Permit with plat valid without expiration ☐   Improvement Permit with site plan valid for sixty months ☑   Authorization to Construct is valid for a period equal to that of Improvement Permit - not to exceed sixty months.

Signed: [signature] date 6/19/08   Installed by: Richard Abernathy

Improvement Permit by: Anthony Coker Jr. date 6/19/08   Operation Permit by: [signature] REHS date 5/21/2010

Authorization to Construct by: Anthony Coker Jr. date 6/19/08   Existing System Inspection by: date

HEALTH DEPT. COPY: WHITE   OWNER COPY (FINAL): YELLOW   OWNER COPY (INITIAL): PINK