IREDELL COUNTY HEALTH DEPARTMENT

STATESVILLE 704-878-5305 MOORESVILLE 704-664-5281

IMPROVEMENT PERMIT / CERTIFICATE OF COMPLETION / OPERATION PERMIT / EXISTING SYSTEM INSPECTION

PROPERTY DESCRIPTION NO. 18262 DATE April 19, '94 TAX MAP NO. 2C+B16 4624 89 5181 Watershed: ☑ Yes ☐ No

OWNER OR CONTRACTOR Jerry McGrady 4624 89 5181 PHONE: Business 535-0357 Home L.N.

ADDRESS 11510 Belding Dr. Charlotte

LOCATION 1100 TR #101 TR Yacht Harbour Dr. on Right corner Lot w/ Real Lt.

SUBDIVISION Yacht Harbour BLOCK / SECTION LOT 16 LOT AREA 110'X 189' SITE CLASS. PS pr. 1956 DESIGN FLOW 360gpd L.T.A.R. • 3

Septic Tank: 1000 1500 Gallons; STB TP 1011 Date 3-29-94

Pump Tank: Gallons; PT Date

Pump Make: Model Serial No.

Nitrification Field: No Fields 1 Square Feet 1200 Linear Feet 400

No Lines 3 Trench Width 36" Max Trench Bottom Depth 36" Gravel Depth

☑ New System ☐ Repair System Type: I, II, III, IV, V, VI

System Description: gravity conventional

Repair System Description: gravity PPBLS

Maintenance Agreement Required: ☐ Yes ☑ No

☑ House/Mod. Home No. Bedrooms 3

☐ Mobile Home No. Bathrooms 3½

☐ Business No. Employees

☐ Other


☑ Slab ☐ Crawl Space ☐ Basement w/plumbing ☐ Basement wo/plumbing

Water Supply: ☑ Individual ☐ Community ☐ Public

Comments:

Comments: 1500gal ST. installed.

INITIAL SITE SKETCH

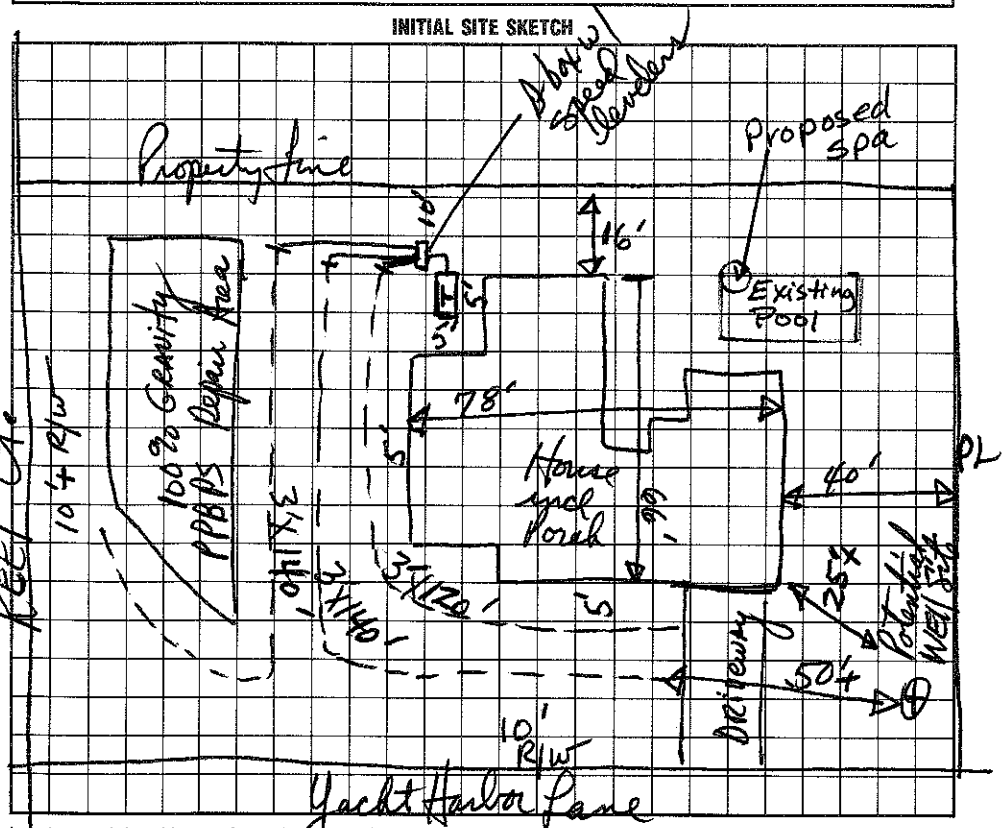

AS BUILT SKETCH

As shown on initial sketch

The proposed / existing Spa addition does not appear to impact the existing septic system.

**NOTE:

Amy Melville R.S.

Date: April 19, 2013

ICHD-Environmental Health Division

I understand that this permit can be suspended or revoked if any false information is supplied toward securing the permit/any unauthorized changes are made to the site/any unauthorized changes are made in the installation of the system. Improvement Permit is valid for 60 months from date of issuance.

Signed: X

Improvement Permit by: Mark R. Johnson, RS date 4/19/94

Existing System Inspection by: date

Installed by: Richard Abernathy

Certificate of Completion by: Mark R. Johnson, RS date 6-14-95

Operation Permit by: date

HEALTH DEPT. COPY: WHITE INSPECTION COPY (FINAL): GREEN OWNER COPY (FINAL): YELLOW INSPECTION COPY (INITIAL): PINK OWNER COPY (INITIAL): GOLD