IREDELL COUNTY HEALTH DEPARTMENT

AUTHORIZATION 4624895251 9:30 - 100

STATESVILLE 704-878-5305 MOORESVILLE 704-664-5281

IMPROVEMENT PERMIT / ~~CERTIFICATE OF COMPLETION~~ / OPERATION PERMIT / EXISTING SYSTEM INSPECTION

PROPERTY DESCRIPTION NO. 10861 DATE 9/12/96 TAX MAP NO. 2C-1-B-17

OWNER OR CONTRACTOR PETER DOLBY PHONE: Business _____ Home 366-3789 Watershed: ☑ Yes ☐ No

ADDRESS 400 BRACKENBURY LN CHARLOTTE NC 28226

LOCATION BRAWLEY SCHOOL RD - TL YACHT RD - TR YACHT HARBOUR - TR KEEL RD - ON RT

SUBDIVISION YACHT HARBOUR BLOCK / SECTION C LOT 17 LOT AREA — SITE CLASS PS DESIGN FLOW 360GPD L.T.A.R. .35GPD/FT2

Septic Tank: 1000 Gallons; STB 794 Date 4-16-97

Pump Tank: _____ Gallons; PT _____ Date _____

Pump Make: _____ Model _____ Serial No. _____

Nitrification Field: No Fields 1 Square Feet 926 Linear Feet 342

No Lines 4 Trench Width 36" Max Trench Bottom Depth 36" Gravel Depth 12"

☑ New System ☐ Repair System Type: I, II, III, IV, V, VI

System Description: GRAVITY CONVENTIONAL

Repair System Description: PANEL

Maintenance Agreement Required: ☐ Yes ☑ No

☑ House/Mod. Home ☐ Mobile Home ☐ Business ☐ Other

No. Bedrooms 3 No. Bathrooms 2.5 No. Employees ____


☐ Slab ☑ Crawl Space ☐ Basement w/plumbing ☐ Basement wo/plumbing

Water Supply: ☑ Individual ☐ Community ☐ Public


Comments: Tanks 1st 3 lines checked 7/21/97
Additional lines & D-box checked 7/22/97 mz

Comments: Installed as drawn

INITIAL SITE SKETCH

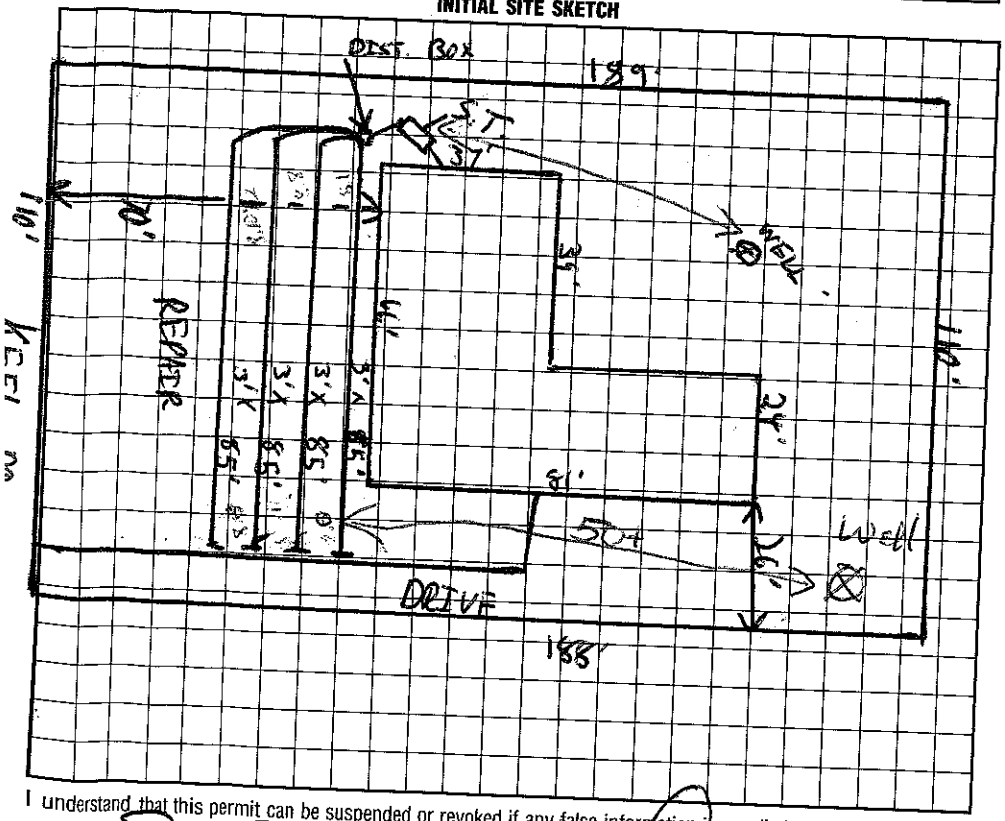

AS BUILT SKETCH

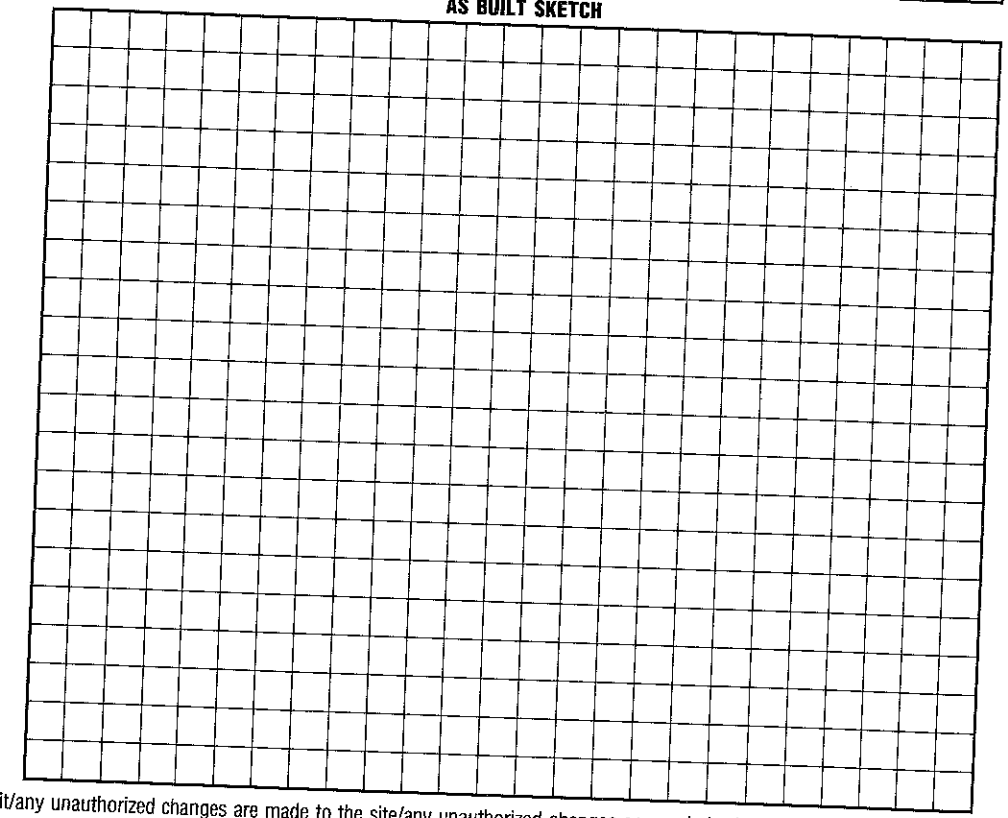

I understand that this permit can be suspended or revoked if any false information is supplied toward securing the permit/any unauthorized changes are made to the site/any unauthorized changes are made in the installation of the system.

Signed: PETER DOLBY By _____

Improvement Permit by: _____ EHS date 9/12/96

~~Existing System Inspection by:~~ AUTH. TO CONSTRUCT _____ EHS date 9/12/96

Installed by: E.J. ERVIN

Certificate of Completion by: _____ date 7/22/97

Operation Permit by: _____ date 7/25/97

HEALTH DEPT. COPY: WHITE INSPECTION COPY (FINAL): GREEN OWNER COPY (FINAL): YELLOW INSPECTION COPY (INITIAL): PINK OWNER COPY (INITIAL): GOLD