(Bobby Daniels) - 525-1655

IREDELL COUNTY HEALTH DEPARTMENT

AUTHORIZATION TO CONSTRUCT

(2:00)

STATESVILLE 704-878-5305 MOORESVILLE 704-664-5281

IMPROVEMENT PERMIT / ~~CERTIFICATE OF COMPLETION~~ / OPERATION PERMIT / EXISTING SYSTEM INSPECTI

PROPERTY DESCRIPTION NO. 25829 DATE 1/17/97 TAX MAP NO. 4624896486 Watershed: ☑ Yes ☐

OWNER OR CONTRACTOR DONALDSON & ASSOCIATES PHONE: Business 525-1155 Home

ADDRESS 2531 FOREST DR CHARLOTTE NC 28209

LOCATION BRAWLEY SCHOOL RD - TL YACHT HARBOR FR 4TH ON RT BEGIN YACHT HARBOR DR.

SUBDIVISION YACHT HARBOUR BLOCK / SECTION LOT 3 LOT AREA .477 AC SITE CLASS. PS DESIGN FLOW 360GPD L.T.A.R. .30 PD/FT

Septic Tank: 1000 Gallons; STB 794 Date 4/16/97

Pump Tank: Gallons; PT Date

Pump Make: Model Serial No.

Nitrification Field: No Fields 1 Square Feet 900 Linear Feet 360

No Lines 4 @ 75' Trench Width 36" Max Trench Bottom Depth 36" Gravel Depth N/A

☑ New System ☐ Repair System Type: I, II, III, IV, V, VI

System Description: GRAVITY CHAMBERED

Repair System Description: PANEL

Maintenance Agreement Required: ☐ Yes ☑ No

☑ House/Mod. Home No. Bedrooms 3

☐ Mobile Home No. Bathrooms 2

☐ Business No. Employees

☐ Other


☐ Slab ☑ Crawl Space ☐ Basement w/plumbing ☐ Basement wo/plumbing

Water Supply: ☑ Individual ☐ Community ☐ Public


Comments:

Comments:

INITIAL SITE SKETCH 1"=40'

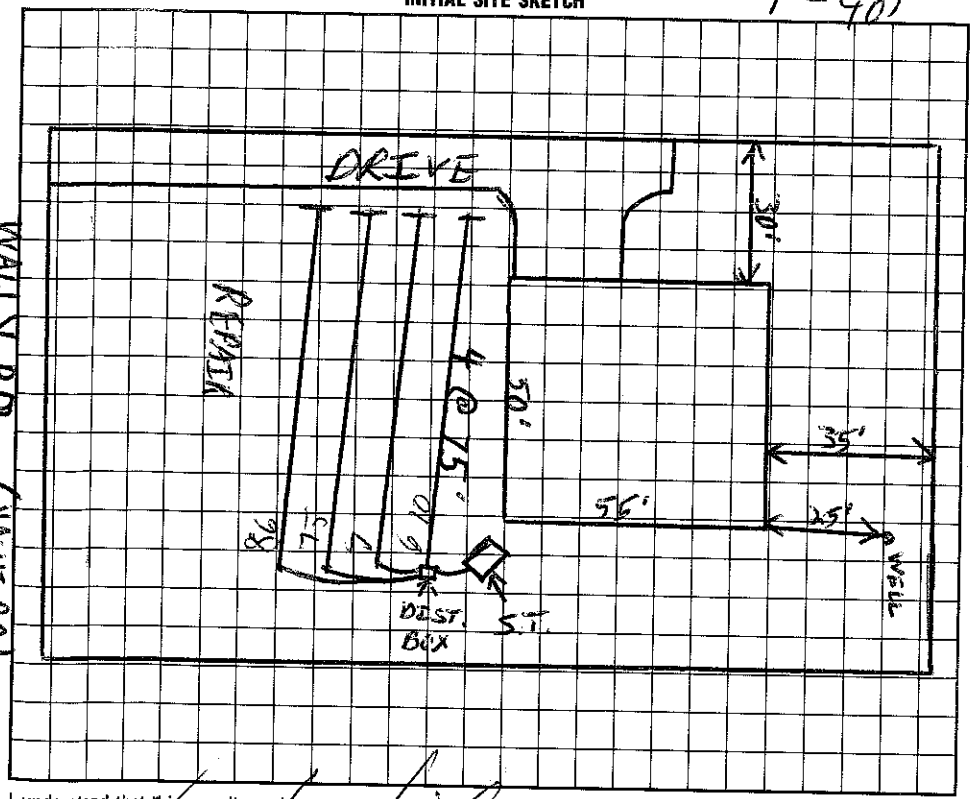

AS BUILT SKETCH

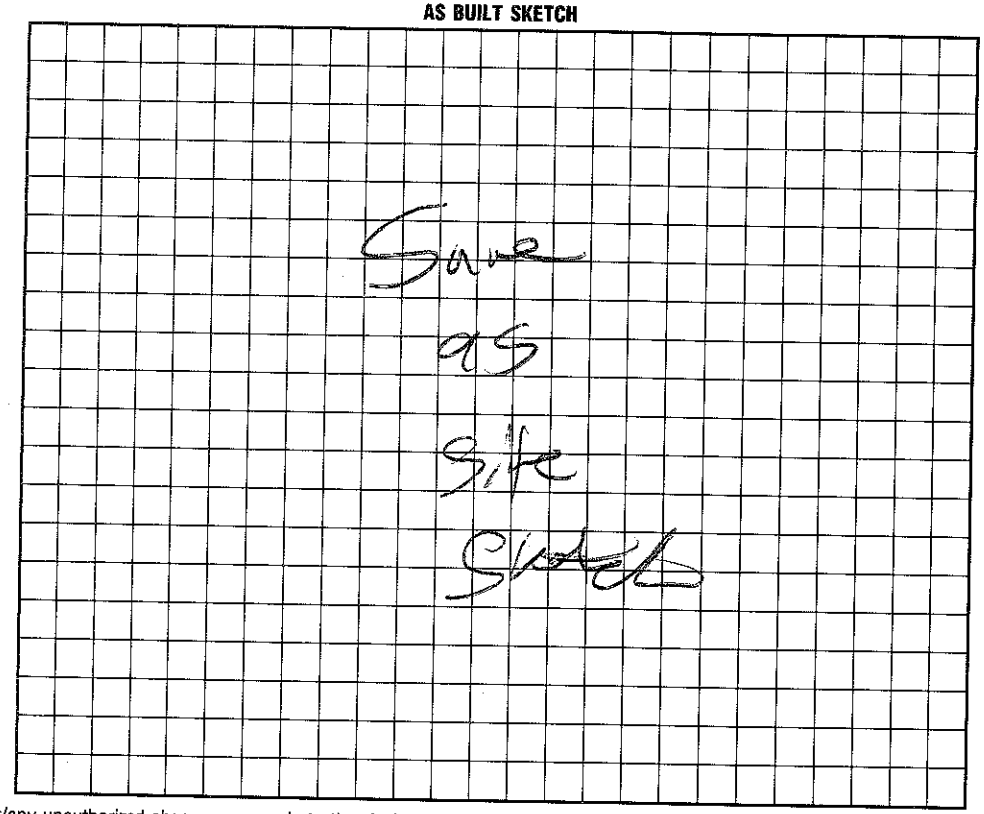

I understand that this permit can be suspended or revoked if any false information is supplied toward securing the permit/any unauthorized changes are made to the site/any unauthorized changes are made in the installation of the system. Improvement Permit is valid for 60 months from date of issuance.

Signed:

Improvement Permit by: EHSE date 1/17/97

AUTHORIZATION TO CONSTRUCT

Existing System Inspection by: EHSE date 1/17/97

Installed by: DENVER PLUMBING

Certificate of Completion by: date

Operation Permit by: date 1/24/97

HEALTH DEPT. COPY: WHITE INSPECTION COPY (FINAL): GREEN OWNER COPY (FINAL): YELLOW INSPECTION COPY (INITIAL): PINK OWNER COPY (INITIAL): GOLD