IREDELL COUNTY HEALTH DEPARTMENT

Statesville Office (704) 878-5305 ALT Mooresville Office (704) 660-3625 PERMIT # 210365

IMPROVEMENT PERMIT / AUTHORIZATION TO CONSTRUCT / OPERATION PERMIT / EXISTING SYSTEM

PIN # 4624-89-6627

APPLICANT: IQ Custom Construction APPLICANT ADDRESS: 890 Edmiston Rd Mt. Ulla

SITE ADDRESS: ~~14 Sterling Oak~~ 250 Yacht Rd. PHONE: 980-297-2329 ALT. PHONE:

SITE DIRECTIONS: BSR, TL Yacht, on R

SUBDIVISION: Yacht Shores SECTION: 1 LOT # 1 LOT AREA: .64 AC DESIGN FLOW: 480 L.T.A.R.: .5

Septic Tank	1000 (gal)	STB	825	Date	9-7-15	☒ New System	☐ Repair	☐ Expansion	System Type: I II (III) IV V VI	☒ Residence	No. Bedrooms 4
Pump Tank	(gal)	PT		Date		System Description:			25% Reduction	☐ Business	No. Persons
Pump Make		Model		Serial #		Repair System Description:			Panel Block	☐ Other	No. Employees
# Nitrification Fields	1	# Lines	5 @ 80'	Linear Ft:	400'	Maintenance Agreement Required:	☐ YES	☒ NO		☐ Slab	☒ Crawl Space
Trench Width	36"	Max. Trench Bottom Depth	24"	Gravel Depth	—		☒ GRAVITY	☐ PRESSURE		☐ Basement w/plumbing	☐ Basement w/o plumbing

Water Supply: ☒ Private ☐ Public ☐ Community

Comments / Conditions:

INITIAL SITE SKETCH

See Plan From Tony Jacobs

AS BUILT SKETCH

Permit can be suspended or revoked if any false information is supplied toward securing the permit / any unauthorized changes are made to the site / any unauthorized changes are made in the installation of the system. **CONTACT A LOCATOR SERVICE PRIOR TO ANY EXCAVATION**

☐ **IMPROVEMENT PERMIT** *with plat valid without expiration.* ☐ **IMPROVEMENT PERMIT** *with site plan valid for 60 mos.* ☒ **AUTHORIZATION TO CONSTRUCT** *valid for period equal to IMPROVEMENT PERMIT--not to exceed 60 mo.*

Owner / Applicant Signature: [signature] Date: 8/3/15 Installed by: Rowan


IMPROVEMENT PERMIT by: [signature] APPROVED Date: JUL 29 2015 OPERATION PERMIT by: [signature] APPROVED Date: DEC 09 2015

AUTHORIZATION TO CONSTRUCT by: [signature] APPROVED Date: JUL 29 2015 Existing System Inspected by: Date:

Health Dept. Copy - WHITE Applicant (Final Approval) - YELLOW Applicant (Conditional Approval) - PINK

APPROVED JUL 31 2015

1"=40'

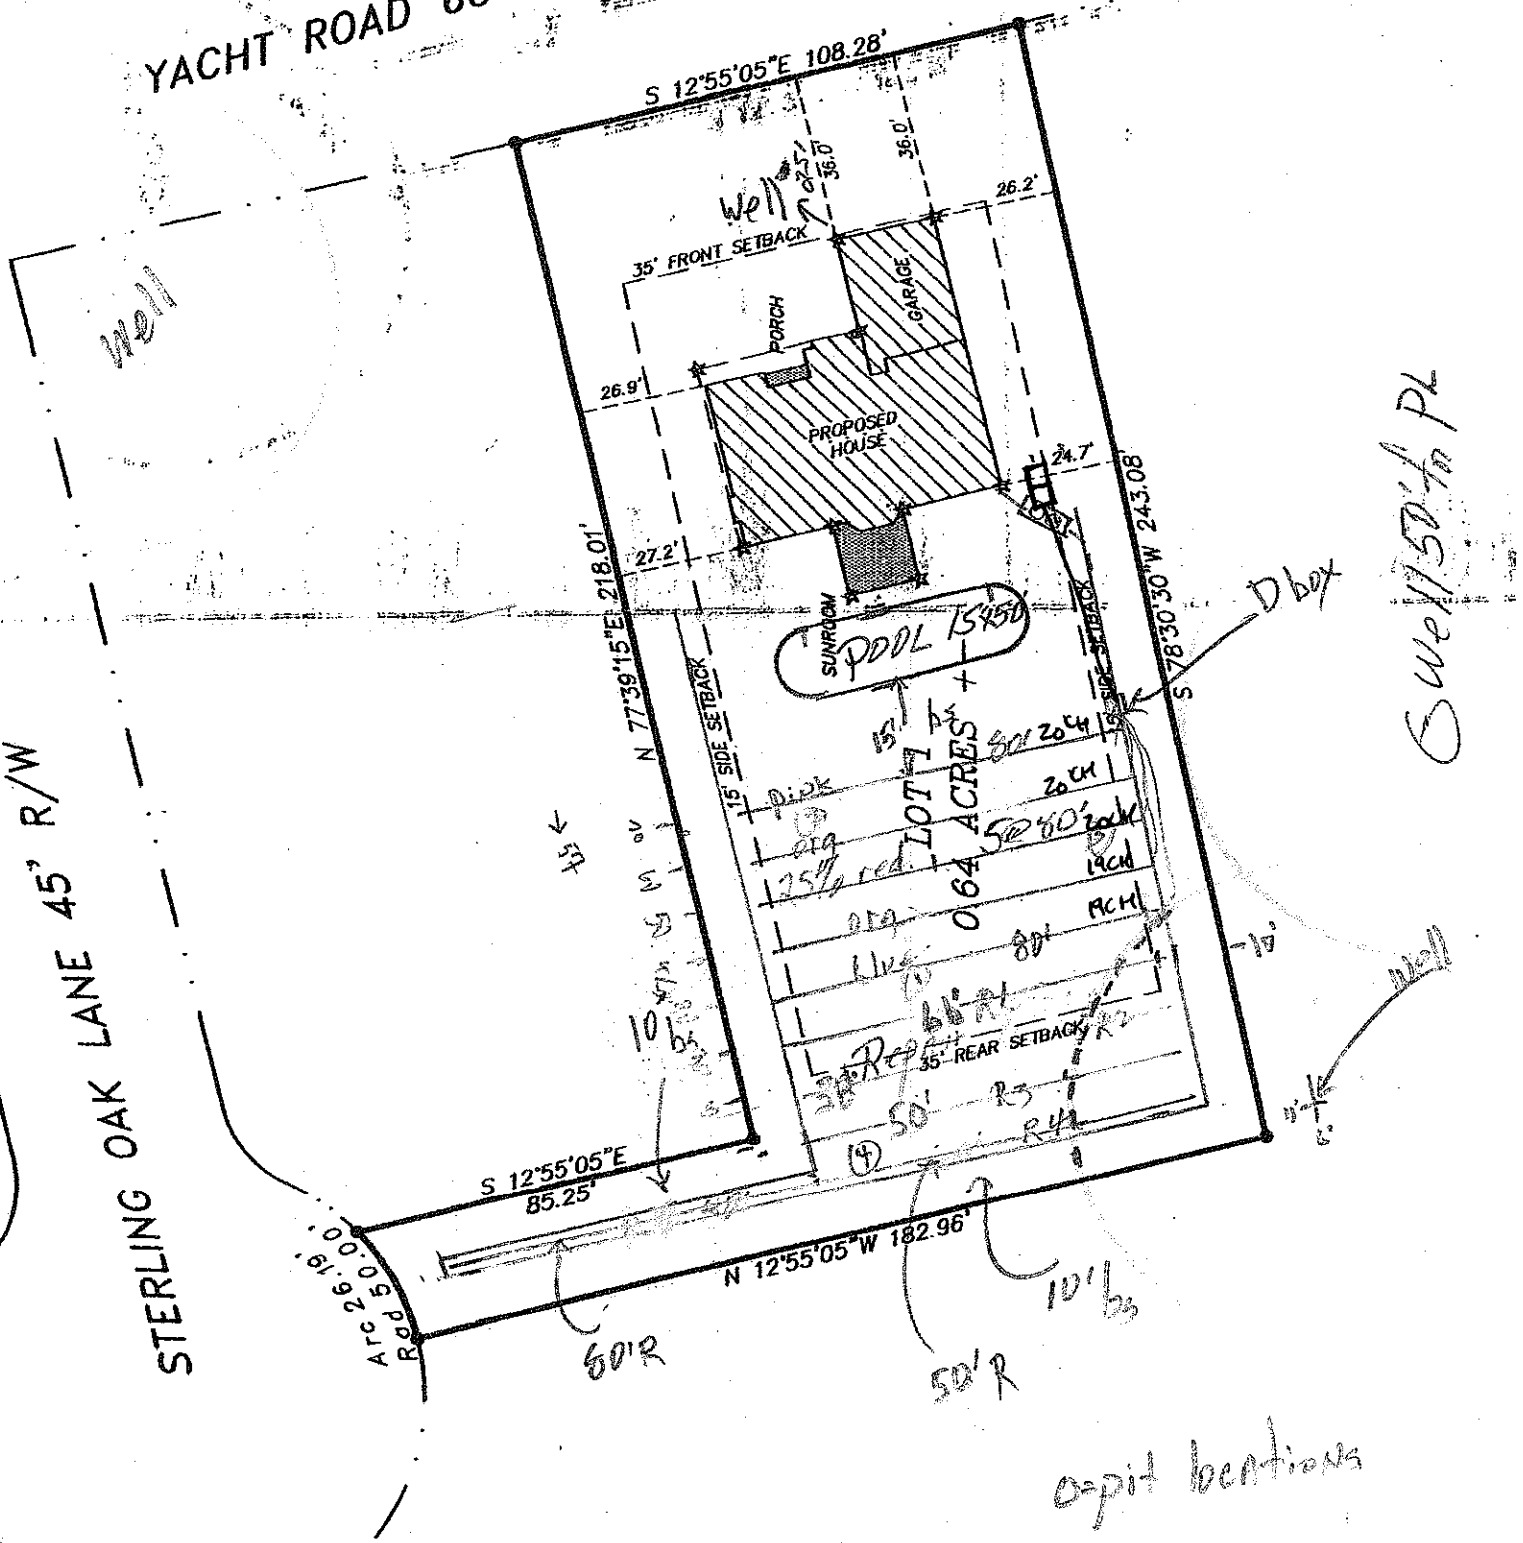

septic locations