IREDELL COUNTY HEALTH DEPARTMENT


ENVIRONMENTAL HEALTH DIVISION

PAGE 2: *SITE PLAN WORKSHEET*

SEE THE "SAMPLE SITE PLAN" BELOW. *INCOMPLETE SITE PLANS WILL BE RETURNED TO YOU FOR COMPLETION AND MAY RESULT IN A DELAY IN THE ISSUANCE OF YOUR SEPTIC SYSTEM PERMIT!!!*

Place an (X) beside each item as you complete the site plan:

- (X) Property Line measurements are clearly identified
- (X) All proposed structures are indicated
- (X) Front and side setbacks from property line
- (X) Preferred driveway location and well location
- (X) Area you prefer your septic system to be placed
- ( ) North arrow, or other sufficient indicator of direction

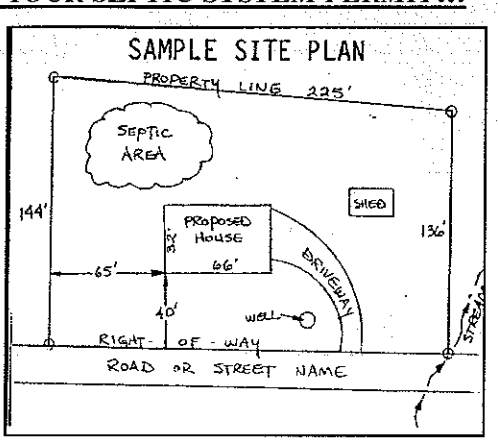

Circle N/A on the following if appropriate:

- Location of septic systems and wells within 100' of your property — N/A
- Location of easements and rights of ways on your property — N/A
- Location of any designated wetlands on the property — N/A

USE THIS SPACE TO DRAW YOUR SITE PLAN

Show: proposed house or business footprint, wells, water lines, patios, pools and decks, and any other item that will occupy space on the site

See Redlined Attached.

Signature: _____

Property owner or owner's legal representative signature (SIGNATURE REQUIRED)

5/8/15

DATE

APPROVED JUL 31 2015

SA

1"=40'

