IREDELL COUNTY HEALTH DEPARTMENT

Agricultural to Construct

4624 89 6718

STATESVILLE 704-878-5305 MOORESVILLE 704-664-5281

IMPROVEMENT PERMIT / CERTIFICATE OF COMPLETION / OPERATION PERMIT / EXISTING SYSTEM INSPECTION

PROPERTY DESCRIPTION NO. 21185 DATE 12/29/95 TAX MAP NO. 2C A 3 Watershed: ☒ Yes ☐ No

OWNER OR CONTRACTOR Earl C Jehcoley PHONE: Business Home 847 - 4178

ADDRESS 1026 Hollybrook Dr. Matthews, NC. 28105

LOCATION Brew Sch TL on Yacht Rd. TR Sterling Oak Ln. to first lot on (L)

SUBDIVISION Yacht Shores BLOCK / SECTION I LOT 2 LOT AREA .53 SITE CLASS PS DESIGN FLOW 360 L.T.A.R. .3

Septic Tank: ____ Gallons; STB 794 Date 2/9/96

Pump Tank: ____ Gallons; PT ____ Date ____

Pump Make: ____ Model ____ Serial No. ____

Nitrification Field: No Fields 1 Square Feet 1200 Linear Feet *300 (400)

No Lines 4 Trench Width 36" Max Trench Bottom Depth 36" Gravel Depth 6" SAND

☒ New System ☐ Repair System Type: I, II, (III) IV, V, VI

System Description: GRAVITY - INFILTRATOR

Repair System Description: PPBS 16'

Maintenance Agreement Required: ☐ Yes ☒ No

☒ House/Mod. Home No. Bedrooms 3

☐ Mobile Home No. Bathrooms 2.5

☐ Business No. Employees ____

☐ Other ____


☐ Slab ☒ Crawl Space ☐ Basement w/plumbing ☐ Basement wo/plumbing

Water Supply: ☒ Individual ☐ Community ☐ Public


Comments: * 25% reduction for infiltrator use
Sand must be placed around louvers for backfill

Comments:

INITIAL SITE SKETCH

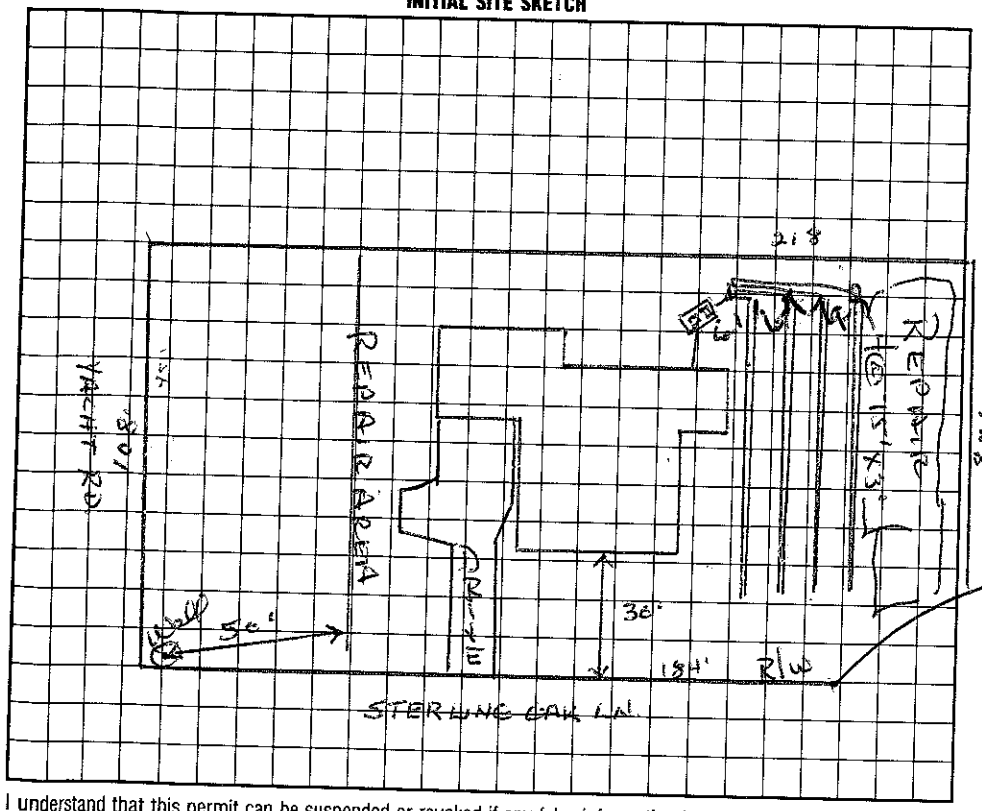

AS BUILT SKETCH

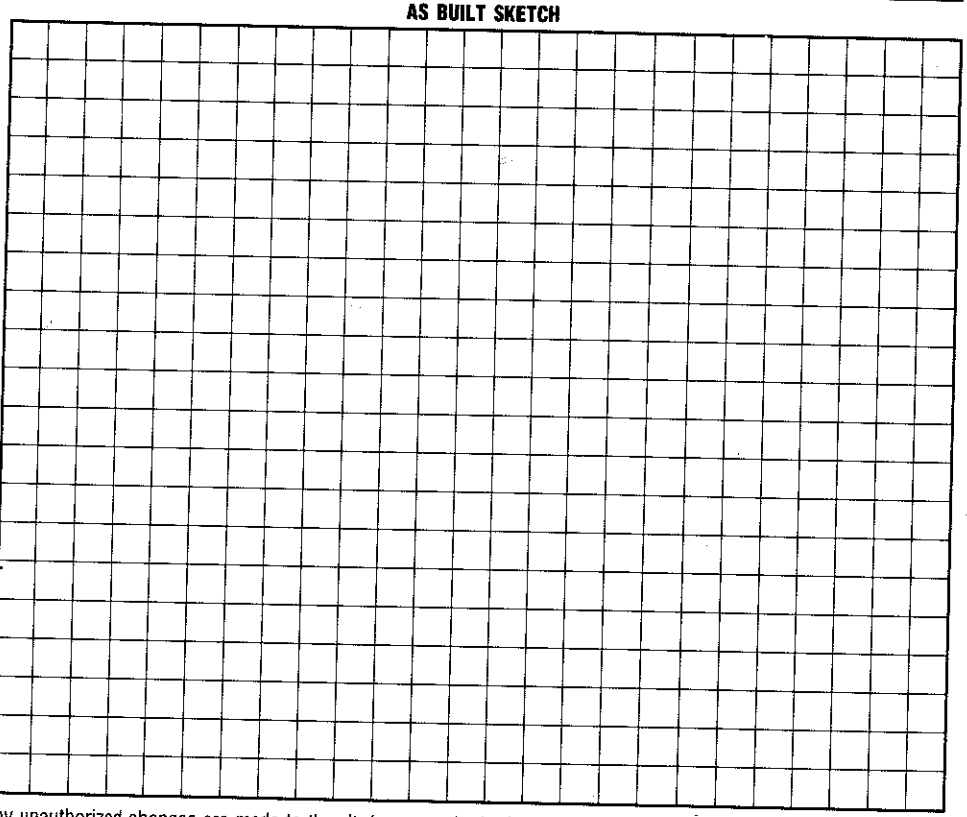

I understand that this permit can be suspended or revoked if any false information is supplied toward securing the permit/any unauthorized changes are made to the site/any unauthorized changes are made in the installation of the system.

Signed: Ray Kelly

Improvement Permit by: Wesley Sparks RS. date 12/29/95

~~Existing System Inspection By:~~ Final Inspect Wesley Sparks RS. date 12/29/95

Installed by: Chris Hedrick

Certificate of Completion by: ____ date ____

Operation Permit by: Wesley Sparks RS. date 8/22/96

HEALTH DEPT. COPY: WHITE INSPECTION COPY (FINAL): GREEN OWNER COPY (FINAL): YELLOW INSPECTION COPY (INITIAL): PINK OWNER COPY (INITIAL): GOLD