IREDELL COUNTY HEALTH DEPARTMENT / Authorization to Construct

STATESVILLE 704-878-5305 MOORESVILLE 704-664-5281

4624 89 7155

IMPROVEMENT PERMIT / ~~CERTIFICATE OF COMPLETION~~ / OPERATION PERMIT / EXISTING SYSTEM INSPECTION

PROPERTY DESCRIPTION NO. 23464 DATE 4/22/96 TAX MAP NO. ~~2004~~ 2C 1 Watershed: [X] Yes [ ] No

OWNER OR CONTRACTOR Steven R White PHONE: Business 704-483-7441 Home

ADDRESS 2547 Wilcox Circle Denver, NC. 28037

LOCATION Brawley Sch Rd. TL Yacht Rd. (R) on ~~Valley Rd~~. TR Yacht Harbour Dr., lot on (R) corner

SUBDIVISION Yacht Harbor BLOCK / SECTION LOT 5 LOT AREA .47AC SITE CLASS. PS DESIGN FLOW 360 L.T.A.R. .3

Septic Tank: 1000 Gallons; STB 794 Date 1/18/91

Pump Tank: Gallons; PT Date

Pump Make: Model Serial No.

Nitrification Field: No. Fields 1 Square Feet 1200 Linear Feet * 300

No Lines *5 Trench Width 36" Max Trench Bottom Depth 32" Gravel Depth SAND

[X] New System [ ] Repair System Type: I, II, III, IV, V, VI

System Description: ~~Chamberd Plastic~~

Repair System Description: Same

Maintenance Agreement Required: [ ] Yes [X] No

[X] House/Mod. Home No. Bedrooms 3

[ ] Mobile Home No. Bathrooms 2.5

[ ] Business No. Employees

[ ] Other

[ ] Slab [X] Crawl Space [ ] Basement w/plumbing [ ] Basement wo/plumbing

Water Supply: [X] Individual [ ] Community [ ] Public

Comments: * Chamberd Plastic 25% reduction


See attached notice!

234 Yacht Rd.


Comments: 5 @ 80' x 3' installed

installed as drawn.

INITIAL SITE SKETCH

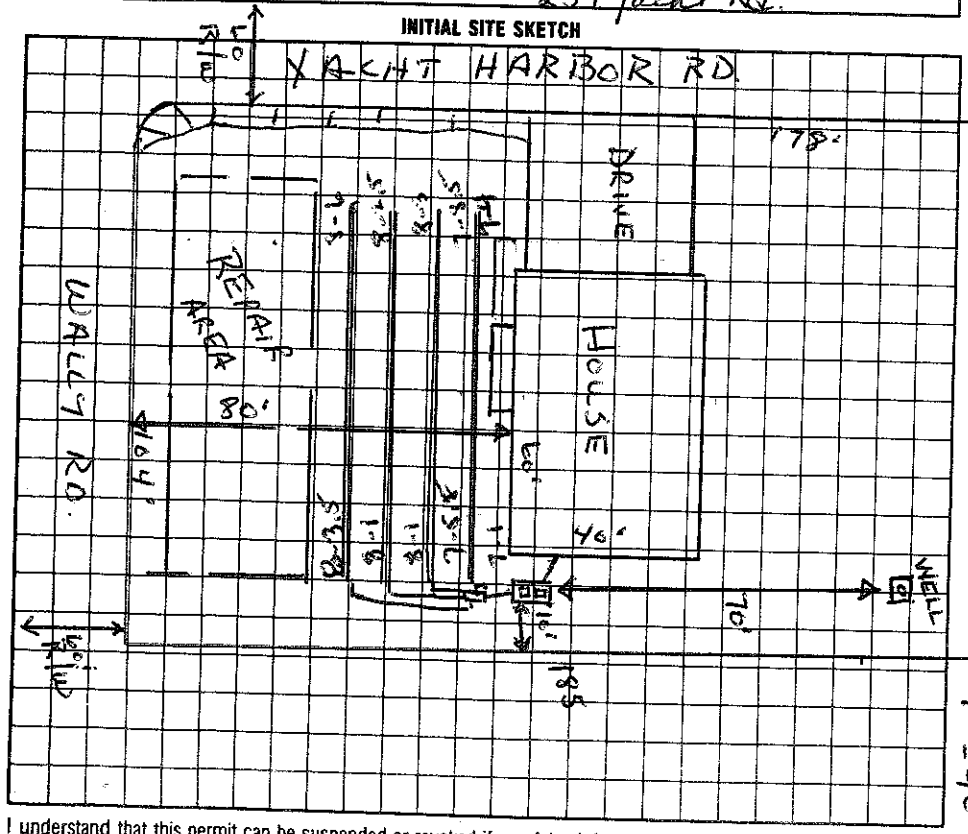

AS BUILT SKETCH

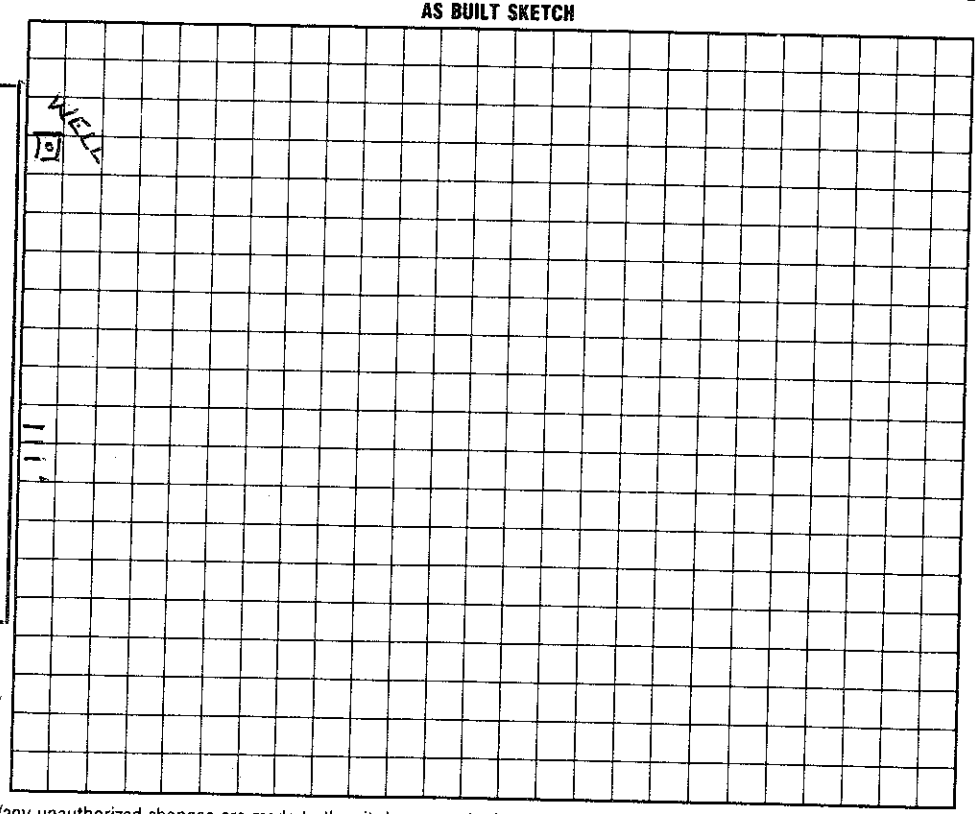

I understand that this permit can be suspended or revoked if any false information is supplied toward securing the permit/any unauthorized changes are made to the site/any unauthorized changes are made in the installation of the system.

Authorization to Construct valid 5 years

Signed: * Steven R. White

Improvement Permit by: date

~~Final~~ System Inspection by: Authorization to Construct Wesley Sparks RS. date 4/22/96

Installed by: Denver Plumbing

Certificate of Completion by: Wesley Sparks RS. date 3/24/97

Operation Permit by: Wesley Sparks RS. date 3/24/97

HEALTH DEPT. COPY: WHITE INSPECTION COPY (FINAL): GREEN OWNER COPY (FINAL): YELLOW INSPECTION COPY (INITIAL): PINK OWNER COPY (INITIAL): GOLD