IREDELL COUNTY HEALTH DEPARTMENT

AUTHORIZATION TO CONSTRUCT

STATESVILLE 704-878-5305 MOORESVILLE 704-664-5281

IMPROVEMENT PERMIT / ~~CERTIFICATE OF COMPLETION~~ / OPERATION PERMIT / EXISTING SYSTEM INSPECTION

PROPERTY DESCRIPTION NO. 25828 DATE 1/17/97 TAX MAP NO. ~~4624 89 7836~~

OWNER OR CONTRACTOR DONALDSON + ASSOCIATES PHONE: Business 525-1655 Home

ADDRESS 2531 FOREST DR : CHARLOTTE 28211 Watershed: ☑ Yes ☐ No

LOCATION HAWLEY SCHOOL - TL YACHT RD - 2ND ON RT BEFORE YACHT HARBOR 4624 89 7236

SUBDIVISION YACHT HARBOR BLOCK / SECTION LOT 4 LOT AREA .477 SITE CLASS. RS DESIGN FLOW 360 GPD L.T.A.R. .30 GPD/FT²

Septic Tank: 1000 Gallons; STB 794 Date 9/26/97

Pump Tank: Gallons; PT Date

Pump Make: Model Serial No.

Nitrification Field: No Fields 1 Square Feet 1200 Linear Feet 400

No Lines 5@80' Trench Width 36" Max Trench Bottom Depth 36" Gravel Depth 12"

☑ New System ☐ Repair System Type: I, II, III, IV, V, VI

System Description: GRAVITY CONVENTIONAL

Repair System Description: GRAVITY PANEL

Maintenance Agreement Required: ☐ Yes ☑ No

☑ House/Mod. Home ☐ Mobile Home ☐ Business ☐ Other

No. Bedrooms 3 No. Bathrooms 2 No. Employees


☐ Slab ☑ Crawl Space ☐ Basement w/plumbing ☐ Basement wo/plumbing

Water Supply: ☑ Individual ☐ Community ☐ Public

Comments:

Comments:

INITIAL SITE SKETCH 1"=40'

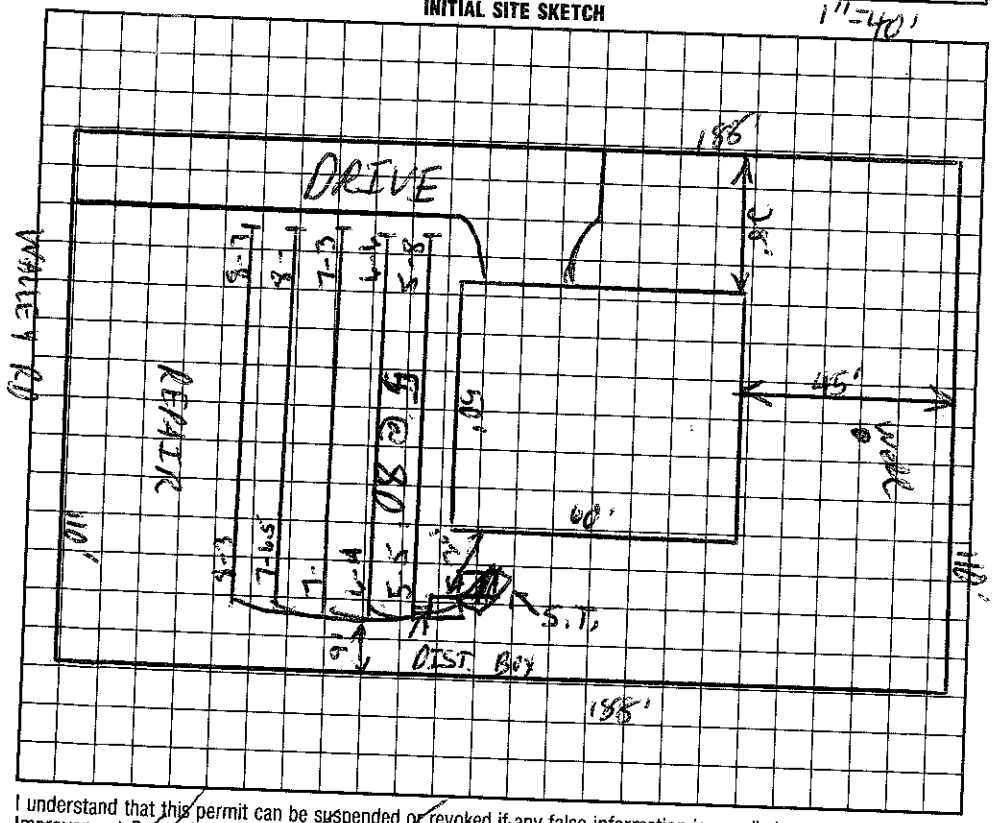

AS BUILT SKETCH

I understand that this permit can be suspended or revoked if any false information is supplied toward securing the permit/any unauthorized changes are made to the site/any unauthorized changes are made in the installation of the system. Improvement Permit is valid for 60 months from date of issuance.

Signed:

Improvement Permit by: date 1/17/97

~~Existing System Inspection by:~~ date 1/17/97

Installed by: Duncan Plumbing

Certificate of Completion by: Wesley Sparks RS date 11/6/97

Operation Permit by: Wesley Sparks RS date 11/6/97

HEALTH DEPT. COPY: WHITE INSPECTION COPY (FINAL): GREEN OWNER COPY (FINAL): YELLOW INSPECTION COPY (INITIAL): PINK OWNER COPY (INITIAL): GOLD