IREDELL COUNTY HEALTH DEPARTMENT

STATESVILLE 704-878-5305 MOORESVILLE 704-664-5281

IMPROVEMENT PERMIT / CERTIFICATE OF COMPLETION / OPERATION PERMIT / EXISTING SYSTEM INSPECTION

PROPERTY DESCRIPTION NO. 6765 DATE July 15, 93

OWNER OR CONTRACTOR Richard W. Smith PHONE: Business 4624 89 7315 TAX MAP NO. 2C1B3

ADDRESS Home

LOCATION 1190 Yadkin Valley Rd. (NC 901) ~½-¾ mile on right

SUBDIVISION Yacht Harbour BLOCK / SECTION LOT 3 LOT AREA 110'x180' SITE CLASS. B pre 1978 L.T.A.R. .3

Water Supply: ☒ Individual ☐ Community ☐ Public

Septic Tank: 1250 Gallons; STB 1013 (1251) Date 2-6-93

Pump Tank: Gallons; PT Date

Nitrification Field: No Fields 1 Square Feet Linear Feet 200+

No. Lines 4 Trench Width 24" Trench Depth ~36" Gravel Depth NA

☒ New System ☐ Repair System Type: I, II, III, IV, V, VI

System Description: gravity PPBPS

Repair System Description: grav. PPBPS

Maintenance Agreement Required: ☐ Yes ☒ No

☒ House/Mod. Home ☐ Mobile Home ☐ Business ☐ Other

No. Bedrooms 3 No. Bathrooms 2 No. Employees

☐ Slab ☒ Crawl Space ☐ Basement w/plumbing ☐ Basement wo/plumbing

Garbage Disposal: ☒ Yes ☐ No

Auto. Dishwasher: ☒ Yes ☐ No


Auto. Washing Machine: ☒ Yes ☐ No

Other

Comments

INITIAL SITE SKETCH

AS BUILT SKETCH

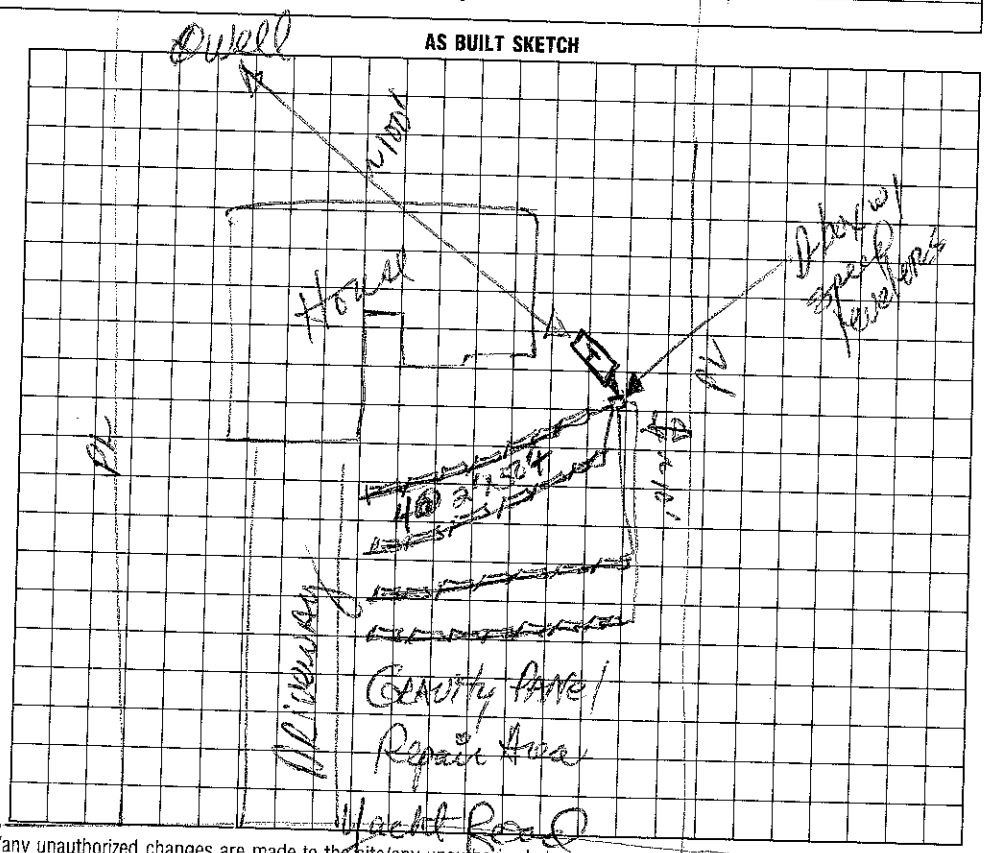

I understand that this permit can be suspended or revoked if any false information is supplied toward securing the permit/any unauthorized changes are made to the site/any unauthorized changes are made in the installation of the system. Improvement Permit is valid for 60 months from date of issuance.

Signed:

Improvement Permit by: date

Existing System Inspection by: date

Installed by: Kenny Williams

Certificate of Completion by: date

Operation Permit by: date 7/15/93

HEALTH DEPT. COPY: WHITE INSPECTION COPY (FINAL): GREEN OWNER COPY (FINAL): YELLOW INSPECTION COPY (INITIAL): PINK OWNER COPY (INITIAL): GOLD