IREDELL COUNTY HEALTH DEPARTMENT

AUTH. TO CONSTRUCT.

4624 89 8778

STATESVILLE 704-878-5305 MOORESVILLE 704-664-5281

IMPROVEMENT PERMIT / ~~CERTIFICATE OF COMPLETION~~ / OPERATION PERMIT / EXISTING SYSTEM INSPECTION

PROPERTY DESCRIPTION NO. 24640 DATE 8/29/96 TAX MAP NO. 3C-2-A-1 Watershed: ☑ Yes ☐ No

OWNER OR CONTRACTOR [redacted] NANTZ BUILDING CO. PHONE: Business 528-6043 Home

ADDRESS 147 NANTZ WOODS LANE TROUTMAN 28166

LOCATION BRAWLEY SCHOOL RD. TL YACHT RD. - AT END ON LEFT.

SUBDIVISION YATCH COVE BLOCK / SECTION LOT 1 LOT AREA SITE CLASS. PS DESIGN FLOW 360 L.T.A.R. .36 PD/FT 2

Septic Tank: 1000 Gallons; STB 1012 Date 10/28/96

Pump Tank: Gallons; PT Date

Pump Make: Model Serial No.

Nitrification Field: No Fields 1 Square Feet 900 Linear Feet 300

No Lines 6 Trench Width 36" Max Trench Bottom Depth 36" Gravel Depth N/A

☑ New System ☐ Repair System Type: I, II, III, IV, V, VI

System Description: GRAVITY CHAMBERED

Repair System Description: PANEL

Maintenance Agreement Required: ☐ Yes ☑ No

☑ House/Mod. Home ☐ Mobile Home ☐ Business ☐ Other

No. Bedrooms 3 No. Bathrooms 2 No. Employees


☐ Slab ☑ Crawl Space ☐ Basement w/plumbing ☐ Basement wo/plumbing

Water Supply: ☑ Individual ☐ Community ☐ Public

Comments:

Comments:

INITIAL SITE SKETCH

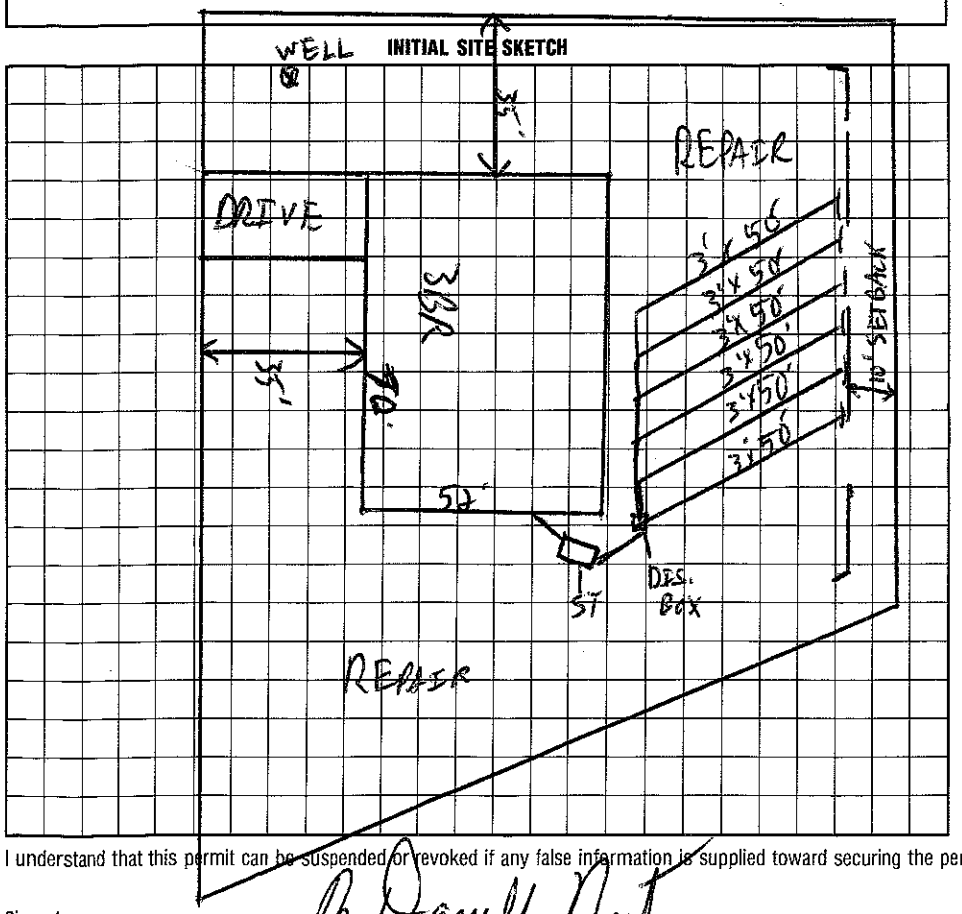

AS BUILT SKETCH

SAME AS SITE SKETCH

I understand that this permit can be suspended or revoked if any false information is supplied toward securing the permit/any unauthorized changes are made to the site/any unauthorized changes are made in the installation of the system.

Signed: B. Darrell Nantz Installed by: TOMMY FRYE

Improvement Permit by: C. Ray Thomas date 8/29/96 Certificate of Completion by: date

Existing System Inspection by: C. Ray Thomas date 8/29/96 Operation Permit by: C. Ray Thomas date 3/31/97

AUTH. TO CONSTRUCT

HEALTH DEPT. COPY: WHITE INSPECTION COPY (FINAL): GREEN OWNER COPY (FINAL): YELLOW INSPECTION COPY (INITIAL): PINK OWNER COPY (INITIAL): GOLD