IREDELL COUNTY HEALTH DEPARTMENT

STATESVILLE 704-878-5305 MOORESVILLE 704-664-5281

IMPROVEMENT PERMIT / AUTHORIZATION TO CONSTRUCT / OPERATION PERMIT / EXISTING SYSTEM INSPECTION

PERMIT# 077789 PIN# 4624 96 5949 DATE 12/17/98

OWNER OR CONTRACTOR Sam J. Baker PHONE: Business Home 304-589-3326

ADDRESS 205 Hummingbird Ave. Princeton, WV 24740

LOCATION Brown Sch. Tl Yacht Rd. to the end

SUBDIVISION ~~Williams~~ Mech Neck BLOCK / SECTION LOT M24 LOT AREA .60 Ac SITE CLASS. PS DESIGN FLOW 360 L.T.A.R. .3

Septic Tank: 1000 Gallons; STB 1012 Date 8-20-99

Pump Tank: 1000 Gallons; PT 17 Date 6-7-99

Pump Make: Myers Model ME 40 Serial No.

Nitrification Field: No Fields 1 Square Feet 765* Linear Feet 255*

No Lines 4 Trench Width 36" Max Trench Bottom Depth 32" Gravel Depth SAND.

[X] New System [ ] Repair System Type: I, II, III, (IV) V, VI

System Description: Pressure – 16" Prof. Panel Bed

Repair System Description: same

Maintenance Agreement Required: [ ] Yes [ ] No

[X] House/Mod. Home [ ] Mobile Home [ ] Business [ ] Other

No. Bedrooms 3 No. Bathrooms 3 No. Employees


[ ] Slab [X] Crawl Space [ ] Basement w/plumbing [ ] Basement wo/plumbing

Water Supply: [X] Individual [ ] Public [ ] Community


Comments:/Conditions: *50% reduction given – Manifold whats shown here on Permit.

Comments:/Conditions: 11/1/99 Checked drainlines. MWS Filter installed, Riser Needs to be installed Pressure checked 8/1/00 MD

INITIAL SITE SKETCH

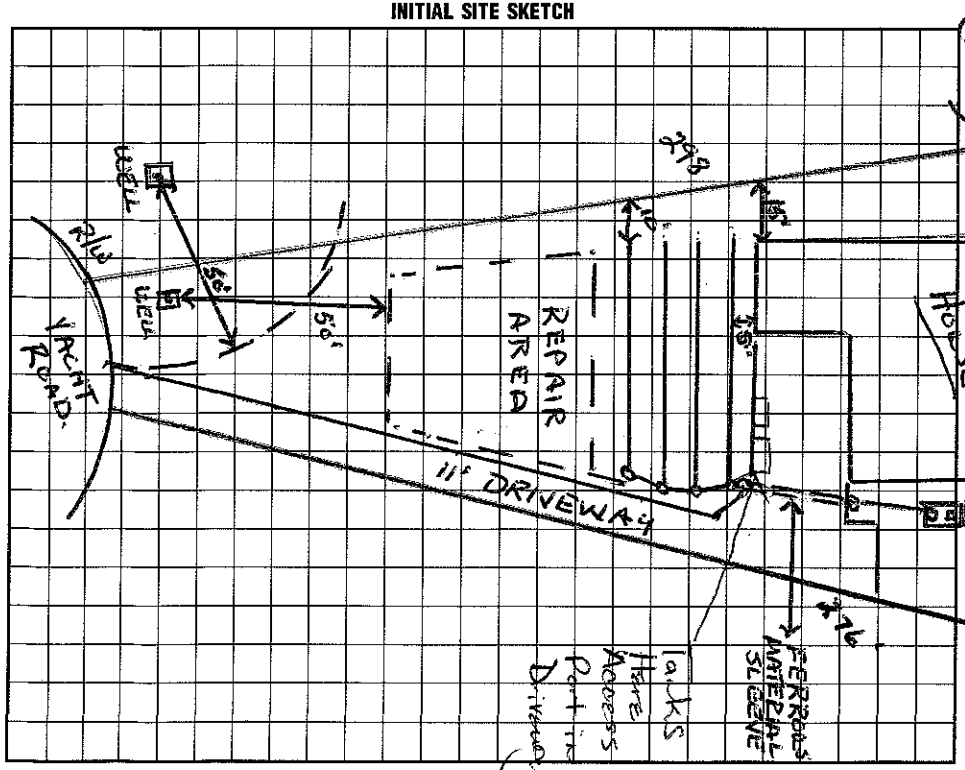

AS BUILT SKETCH

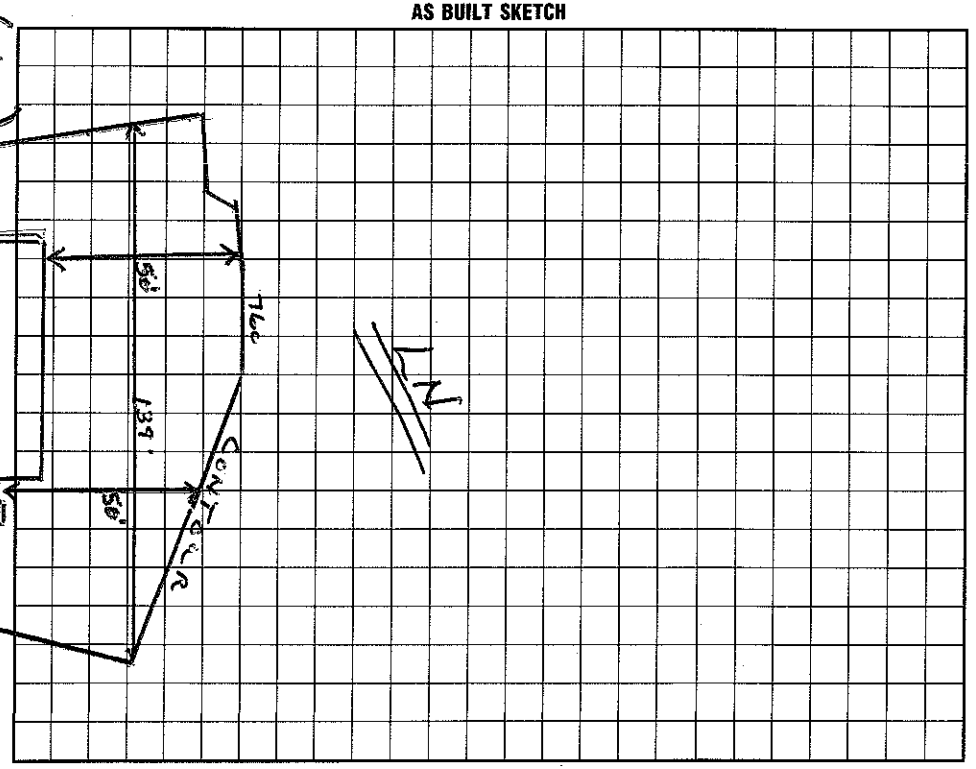

I understand that this permit can be suspended or revoked if any false information is supplied toward securing the permit/any unauthorized changes are made to the site/any unauthorized changes are made in the installation of the system. Improvement Permit with plat valid without expiration. Improvement Permit with site plan valid for sixty months. Authorization to Construct is valid for a period equal to that of Improvement Permit – not to exceed sixty months.

Signed: * Sam Baker date 1/5/99

Improvement Permit by: date

Authorization to Construct by: Wesley Sparks R.S. date 12/17/98

Installed by: Richard Abernathy

Operation Permit by: Maint. Tech Solon R.S. date 8/1/2000

Existing System Inspection by: Wesley Sparks R.S. date 8/11/00

HEALTH DEPT. COPY: WHITE INSPECTION COPY (FINAL): GREEN OWNER COPY (FINAL): YELLOW INSPECTION COPY (INITIAL): PINK OWNER COPY (INITIAL): GOLD