IREDELL COUNTY HEALTH DEPARTMENT

Statesville Office (704) 878-5305 Mooresville Office (704) 660-3625 PERMIT # 216895

IMPROVEMENT PERMIT / AUTHORIZATION TO CONSTRUCT / OPERATION PERMIT / EXISTING SYSTEM

PIN # 4624-96-5949

APPLICANT: Sam Baker APPLICANT ADDRESS: 387 Yacht Rd. Mooresville, NC 28117

SITE ADDRESS: 384 Yacht Rd Mooresville, NC 28117 PHONE: 304-920-7283 ALT. PHONE: —

SITE DIRECTIONS: BSR toward Lake Norman → Left on Yacht Rd → @ end on right side of cul-de-sac


SUBDIVISION: SECTION: LOT # LOT AREA: DESIGN FLOW: L.T.A.R.:

Septic Tank	Ex 1000 (gal)	STB	1012	Date	8-20-99	☐ New System ☐ Repair ☐ Expansion	System Type: I II III (IV) V VI	☒ Residence	No. Bedrooms 3
Pump Tank	Ex 1000 (gal)	PT	17	Date	6-7-99	System Description:	Existing - 50% Reduction	☐ Business	No. Persons 6
Pump Make	Ex Myers	Model	Ex me-40	Serial #		Repair System Description:	Existing - 50% Reduction	☐ Other	No. Employees
# Nitrification Fields	Ex	# Lines	Ex 4	Linear Ft:	Ex 255'	Maintenance Agreement Required:	☒ YES ☐ NO	☐ Slab	☒ Crawl Space
Trench Width	Ex 36"	Max. Trench Bottom Depth	Ex 36"	Gravel Depth	Ex Sand	☐ GRAVITY	☒ PRESSURE	☐ Basement w/ plumbing	☐ Basement w/o plumbing

Water Supply: ☒ Private ☐ Public ☐ Community

Comments / Conditions: Approval for back porch addition/extension of 6' x 30'. Bedroom number (3) taken from ICHD permit # 077789 8-1-2000.

INITIAL SITE SKETCH

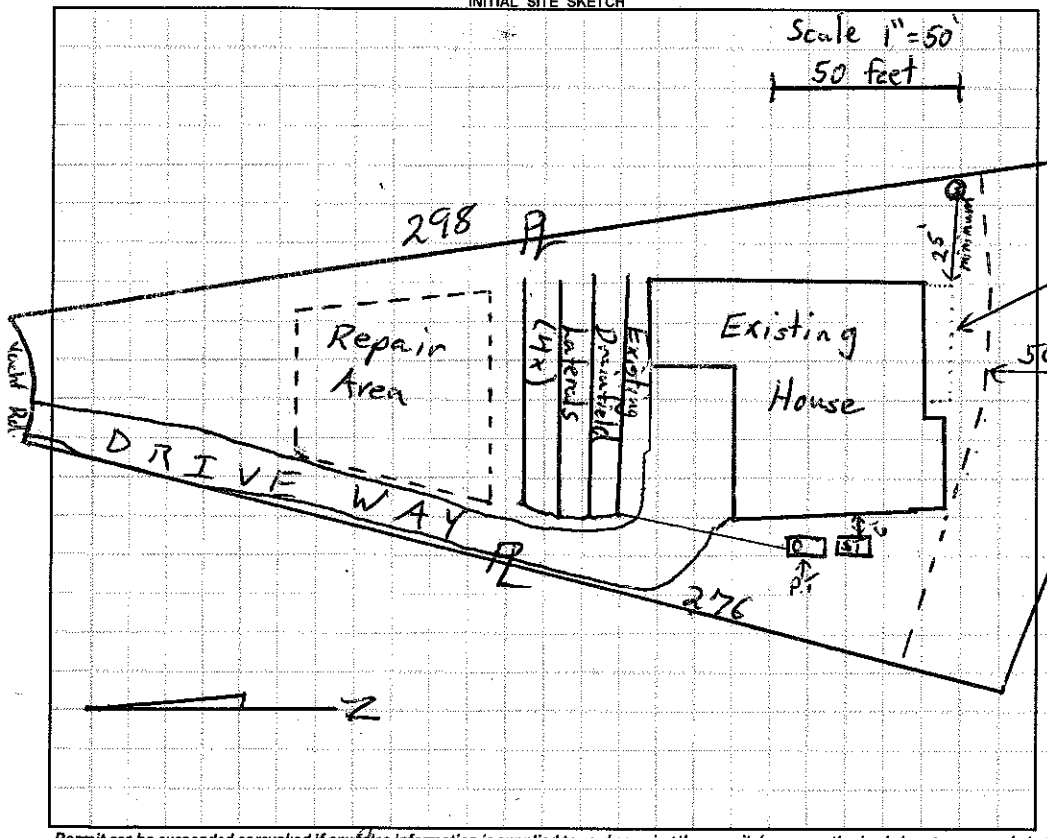

AS BUILT SKETCH

Permit can be suspended or revoked if any false information is supplied toward securing the permit / any unauthorized changes are made to the site / any unauthorized changes are made in the installation of the system. **CONTACT A LOCATOR SERVICE PRIOR TO ANY EXCAVATION**

☐ **IMPROVEMENT PERMIT** *with plat valid without expiration.* ☐ **IMPROVEMENT PERMIT** *with site plan valid for 60 mos.* ☐ **AUTHORIZATION TO CONSTRUCT** *valid for period equal to IMPROVEMENT PERMIT--not to exceed 60 mo.*

Owner / Applicant Signature: Sam Baker Date: 3-31-16 Installed by:

IMPROVEMENT PERMIT by: Date: OPERATION PERMIT by: Date:

AUTHORIZATION TO CONSTRUCT by: Date: Existing System Inspected by: Sam Shuck Date: 3-31-16

Health Dept. Copy - WHITE Applicant (Final Approval) - YELLOW Applicant (Conditional Approval) - PINK