IREDELL COUNTY HEALTH DEPARTMENT

STATE 704-878-5305 130.00 Paid MOORESVILLE 704-664-5281

IMPROVEMENT PERMIT / AUTHORIZATION TO CONSTRUCT / OPERATION PERMIT / EXISTING SYSTEM INSPECTION

PERMIT# 11299 6 PIN# 4624-97-1182 DATE 6/17/03

OWNER OR CONTRACTOR James C. Williams PHONE: Business 704-639-0168 Home

ADDRESS 1602 B. South Boundary St. Salisbury NC 28144

LOCATION Brawley Sch, TL Yacht Rd, TR Wellcraft 1st end

SUBDIVISION Williams BLOCK / SECTION LOT 4/4A LOT AREA 0.46 AC / 0.424 AC SITE CLASS. PS DESIGN FLOW 460 L.T.A.R. 0.5

Septic Tank: 1000 Gallons; STB 825 Date 11/12/04
Pump Tank: 1000 Gallons; PT 308 Date 12/18/03
Pump Make: Zoeller Model Serial No.
Nitrification Field: No Fields 1 Square Feet 1600 Linear Feet 535
No Lines 5@107' Trench Width 36" Max Trench Bottom Depth 36" Gravel Depth 12"

☒ New System ☐ Repair System Type: I, II, (III) IV, V, VI
System Description: Press. Man. Conventional
Repair System Description: Pump 25% Reduction
Maintenance Agreement Required: ☐ Yes ☒ No

☒ House/Mod. Home No. Bedrooms 4
☐ Mobile Home No. Bathrooms 2½
☐ Business No. Employees
☐ Other


☐ Slab ☐ Crawl Space ☒ Basement w/plumbing ☐ Basement wo/plumbing

Water Supply: ☒ Individual ☐ Public ☐ Community


Comments:/Conditions:

Comments:/Conditions:

INITIAL SITE SKETCH

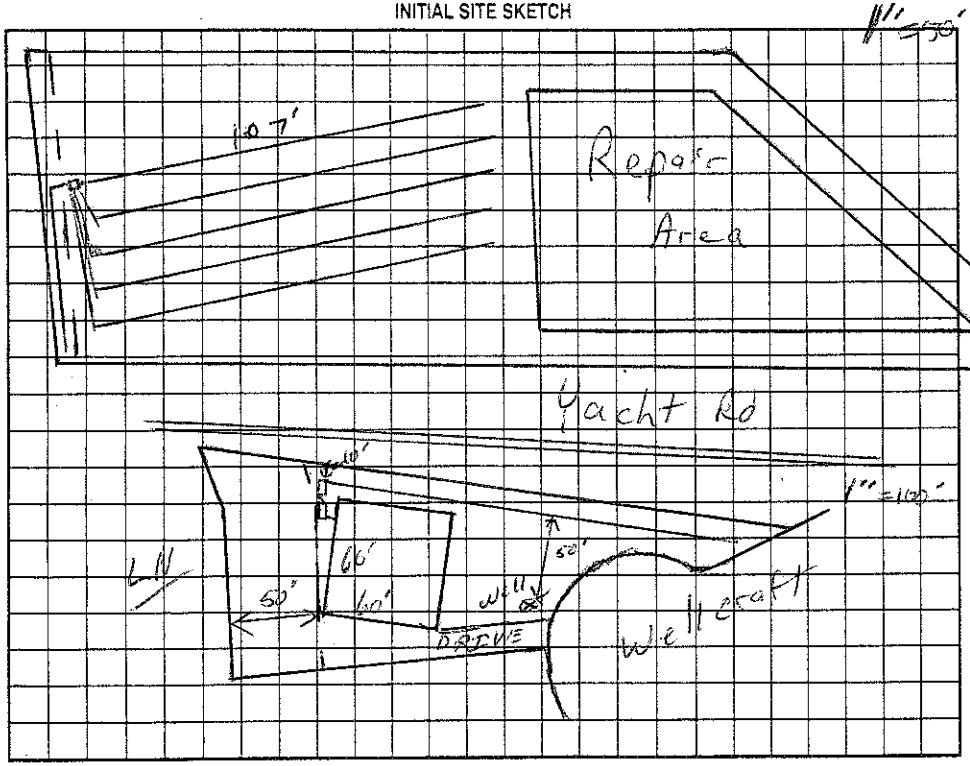

AS BUILT SKETCH

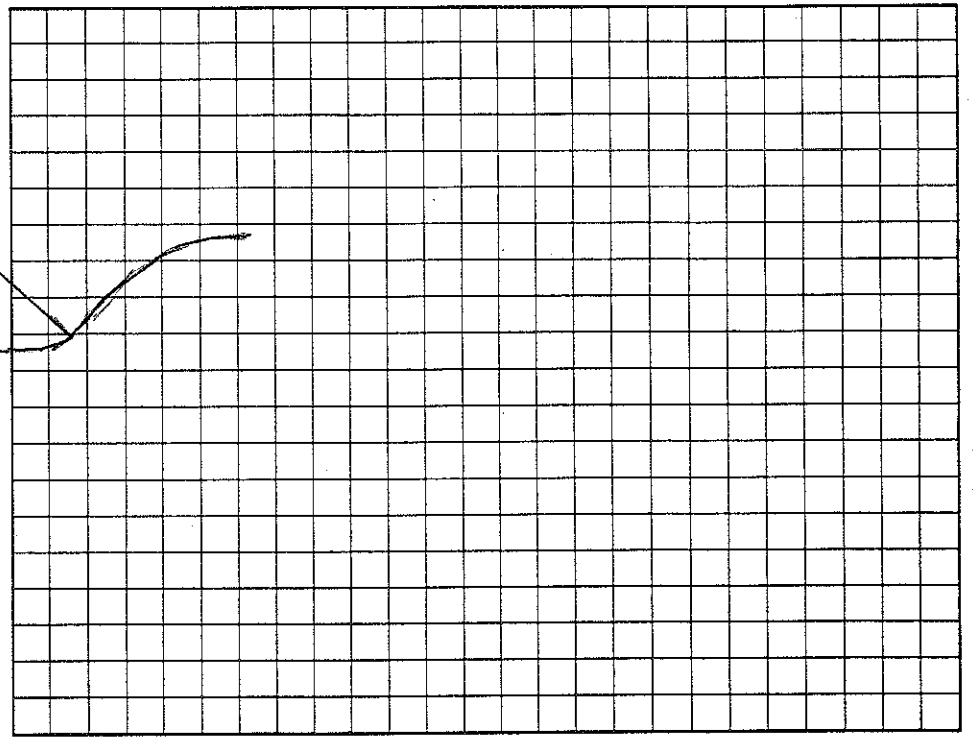

Permit can be suspended or revoked if any false information is supplied toward securing the permit/any unauthorized changes are made to the site/any unauthorized changes are made in the installation of the system. Improvement Permit with plat valid without expiration. Improvement Permit with site plan valid for sixty months. Authorization to Construct is valid for a period equal to that of Improvement Permit – not to exceed sixty months.

Signed: date 7-7-03 Installed by: Barger Sept.c

Improvement Permit by RS date 6/17/03 Operation Permit by: RS date 4/1/04

Authorization to Construct by: RS date 6/17/03 Existing System Inspection by: date

HEALTH DEPT. COPY: WHITE OWNER COPY (FINAL): YELLOW OWNER COPY (INITIAL): PINK