IREDELL COUNTY HEALTH DEPARTMENT

STATESVILLE 704-878-5305 — 130.00 Paid — MOORESVILLE 704-664-5281

IMPROVEMENT PERMIT / AUTHORIZATION TO CONSTRUCT / OPERATION PERMIT / EXISTING SYSTEM INSPECTION

PERMIT# 118031 PIN# 4624-97-2763 DATE

OWNER OR CONTRACTOR Robert J. Baker PHONE: Business Home (304) 425-2385

ADDRESS 226 Sunnyview Ct. Bluefield WV 24701

LOCATION BJR, TL Yacht Rd, TL Sting Ray Ct, on LT.

SUBDIVISION Williams Sub. BLOCK / SECTION LOT 14 LOT AREA 0.75 Ac SITE CLASS. AS DESIGN FLOW 450 L.T.A.R. 0.3

Septic Tank: 1000 Gallons; STB 1007 Date 8/24/04
Pump Tank: Gallons; PT Date
Pump Make: Model Serial No.
Nitrification Field: No Fields 1 Square Feet 1200 Linear Feet 400
No Lines 3@135' Trench Width 36" Max Trench Bottom Depth 36" Gravel Depth —

☒ New System ☐ Repair System Type: I, II, (III), IV, V, VI
System Description: Gravity 25% Red.
Repair System Description: Pedal Block
Maintenance Agreement Required: ☐ Yes ☒ No

☒ House/Mod. Home No. Bedrooms 4
☐ Mobile Home No. Bathrooms 2
☐ Business No. Employees
☐ Other


☐ Slab ☒ Crawl Space ☐ Basement w/plumbing ☐ Basement wo/plumbing

Water Supply: ☒ Individual ☐ Public ☐ Community


Comments:/Conditions:
1" = 50'

Comments:/Conditions:

INITIAL SITE SKETCH

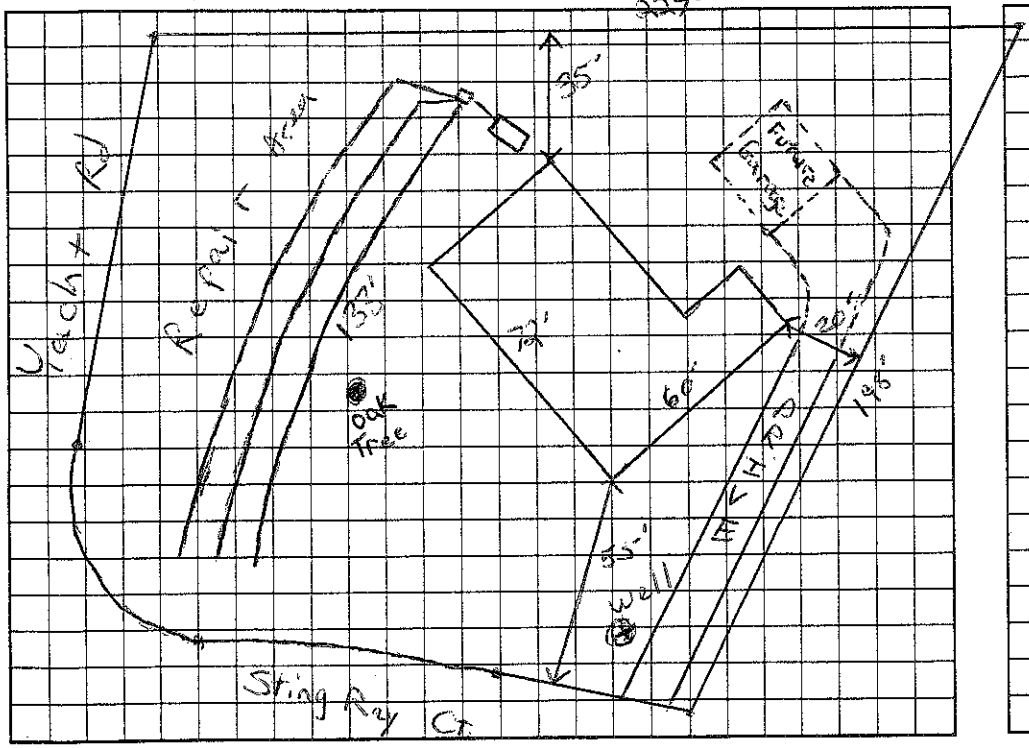

AS BUILT SKETCH

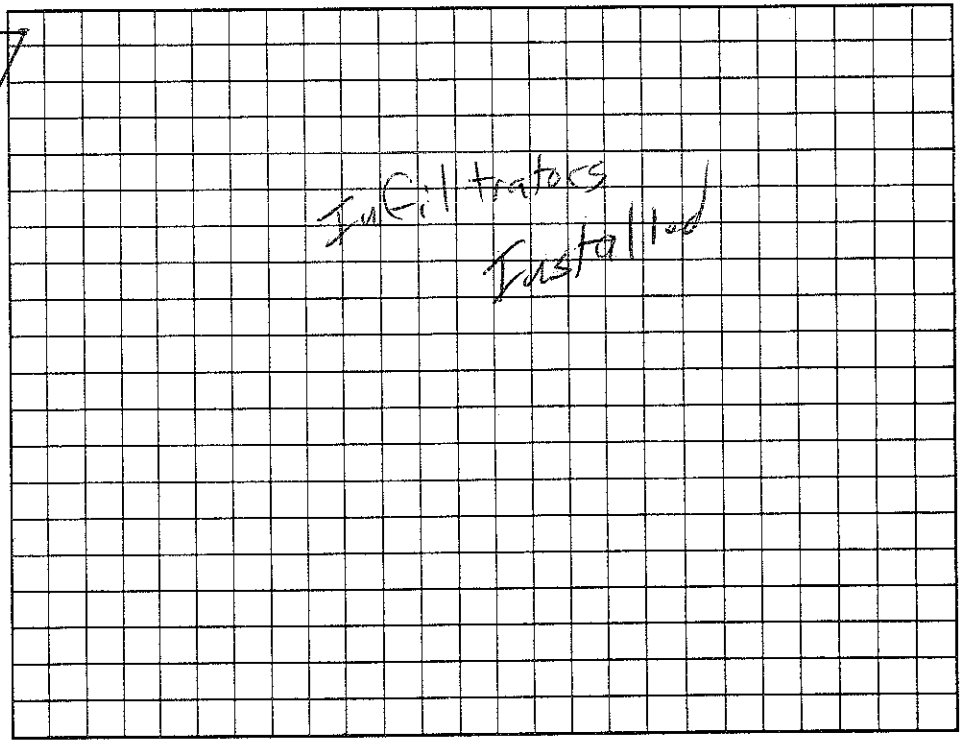

Permit can be suspended or revoked if any false information is supplied toward securing the permit/any unauthorized changes are made to the site/any unauthorized changes are made in the installation of the system. Improvement Permit with plat valid without expiration. Improvement Permit with site plan valid for sixty months. Authorization to Construct is valid for a period equal to that of Improvement Permit – not to exceed sixty months.

Signed: date 5-14-04

Improvement Permit by: RS date 5/3/04

Authorization to Construct by: RS date 5/3/04

Installed by: A+S Grading

Operation Permit by: RS date 11/15/04

Existing System Inspection by: date

HEALTH DEPT. COPY: WHITE OWNER COPY (FINAL): YELLOW OWNER COPY (INITIAL): PINK