IREDELL COUNTY HEALTH DEPARTMENT - *ENVIRONMENTAL HEALTH* ☐ STATESVILLE OFFICE 704-878-5305 ☒ MOORESVILLE OFFICE 704-664-5281

IMPROVEMENT PERMIT / AUTHORIZATION TO CONSTRUCT / OPERATION PERMIT / EXISTING SYSTEM INSPECTION

PERMIT # 169759 PIN # 4674-97-4943 DATE 1-4-12

OWNER LARRY LEWIS APPLICANT: NEWMAN McCADE PHONE: Home/Cell # 704-634-9409 Business #

SITE ADDRESS 117 PELICAN CT OWNER / APPLICANT ADDRESS PO Box 131 MT. MOURNE

SITE DIRECTIONS BSR, YACHT, PELICAN CT

SUBDIVISION MECK-NECK BLOCK / SECTION 6 LOT # 16 LOT AREA .73 AC DESIGN FLOW 480 GAL/DAY L.T.A.R. .3

Septic Tank 1000 Gallons: STB 794 Date 8-20-11

Pump Tank Gallons: P T Date

Pump Make Model Serial #

No. Nitrification Fields: 1 No. Lines 7 Linear Feet 400'

Trench Width 36" Max. Trench Bottom Depth 36" Gravel Depth —

☒ New System ☐ Repair ☐ Expansion System Type I II (III) IV V VI

System Description: 25% REDUCTION

Repair System Description: 50%

Maintenance Agreement Required ☐ YES ☒ NO

☒ GRAVITY ☐ PRESSURE

☒ Residence No. Bedrooms 4

☐ Business No. Persons

☐ Other No. Employees


☐ Slab ☒ Crawl Space

☐ Basement w/plumbing ☐ Basement w/o plumbing

Water Supply: ☒ Private ☐ Public ☐ Community

Comments / Conditions

INITIAL SITE SKETCH

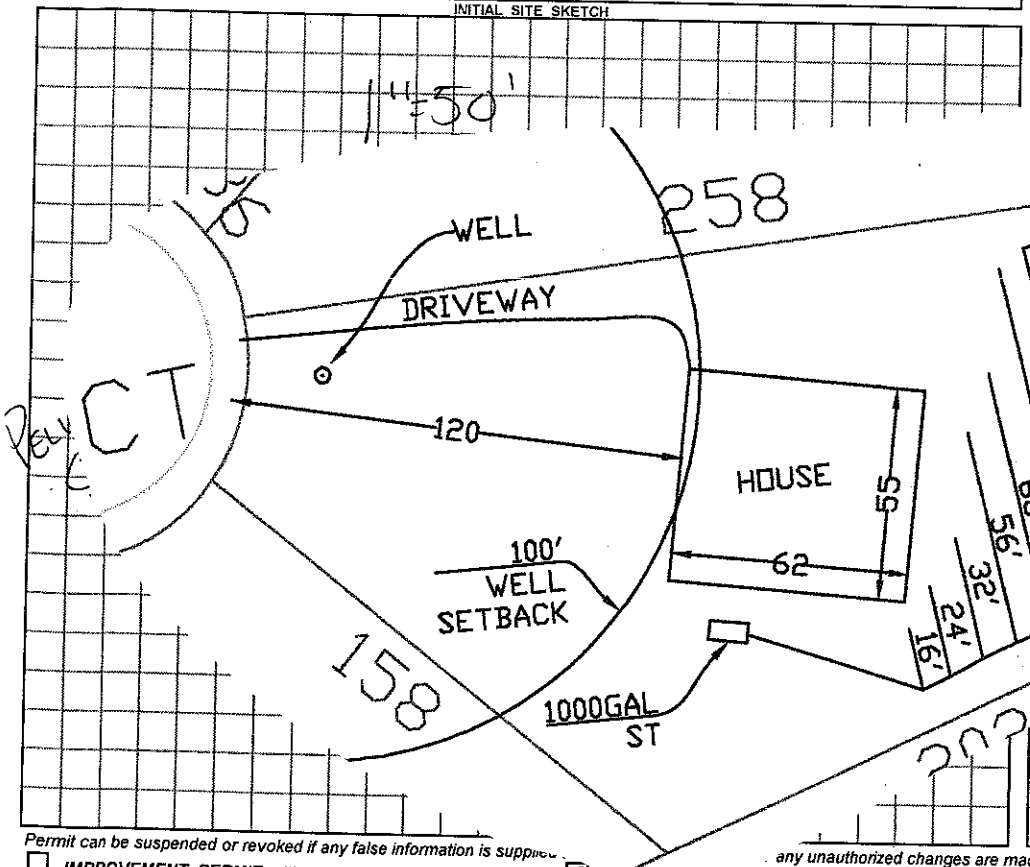

AS BUILT SKETCH

1ST 16'
2ND 24'
3RD 32'
4TH 56'
5TH 68'
6TH 92'
7TH 56'
8TH 56'

Permit can be suspended or revoked if any false information is supplied, any unauthorized changes are made to the site / any unauthorized changes are made in the installation of the system.

☐ ***IMPROVEMENT PERMIT*** with plat valid without expiration. ☐ ***IMPROVEMENT PERMIT*** with plat valid ~~without expiration~~ site plan valid 60 mo. ☒ ***AUTHORIZATION TO CONSTRUCT*** valid for period equal to IMPROVEMENT PERMIT--not to exceed 60 mo.

Owner / Applicant Signature: Newman McCade Date

IMPROVEMENT PERMIT by: REHS Date 1-4-12

AUTHORIZATION TO CONSTRUCT by: REHS Date 1-4-12

YOU SHOULD CONTACT A LOCATOR SERVICE PRIOR TO ANY EXCAVATION

Installed by: ORRISON

OPERATION PERMIT by: REHS Date 4-4-12

Existing System Inspected by: REHS Date

White Copy -- Environmental Health YELLOW COPY (Final) Owner / Applicant PINK COPY (Initial) Owner / Applicant