IREDELL COUNTY HEALTH DEPARTMENT

STATESVILLE 704-878-5305 MOORESVILLE 704-664-5281

IMPROVEMENT PERMIT / AUTHORIZATION TO CONSTRUCT / OPERATION PERMIT / EXISTING SYSTEM INSPECTION

PERMIT # _____ PIN # 4624 97 5777 DATE 7/24/09

OWNER or APPLICANT GENE LANE PHONE: Business _____ Home: 704-650-3376

OWNER or APPLICANT ADDRESS 114 STINGRAY CT. MOORESVILLE, NC. 28117

LOCATION / DIRECTIONS 1100 TL YACHT TR STINGRAY CT. L CENTER OF CUL DE SAC

SUBDIVISION YACHT POINT BLOCK / SECTION _____ LOT # 12 LOT AREA _____ DESIGN FLOW 440 L.T.A.R. _____

Septic Tank _____ Gallons: STB _____ Date _____

Pump Tank _____ Gallons: P T _____ Date _____

Pump Make _____ Model _____ Serial # _____

Nitrification Field No Fields____ No Lines____ Linear Feet _____

Trench Width _____ Max. Trench Bottom Depth _____ Gravel Depth _____

☐ New System ☐ Repair ☐ Expansion System Type I (II) III IV V VI

System Description: _____

Repair System Description: EXISTING SYSTEM

Maintenance Agreement Required ☐ YES ☐ NO

☐ GRAVITY ☐ PRESSURE

☐ Residence No. Bedrooms _____

☐ Business No. Persons _____

☐ Other No. Employees _____

☐ Slab ☐ Crawl Space

☐ Basement w/plumbing ☐ Basement w/o plumbing

Water Supply

☐ Private

☐ Public

☐ Community


Comments / Conditions

Comments / Conditions

NECK RECORD ATTACHED

INITIAL SITE SKETCH

AS BUILT SKETCH

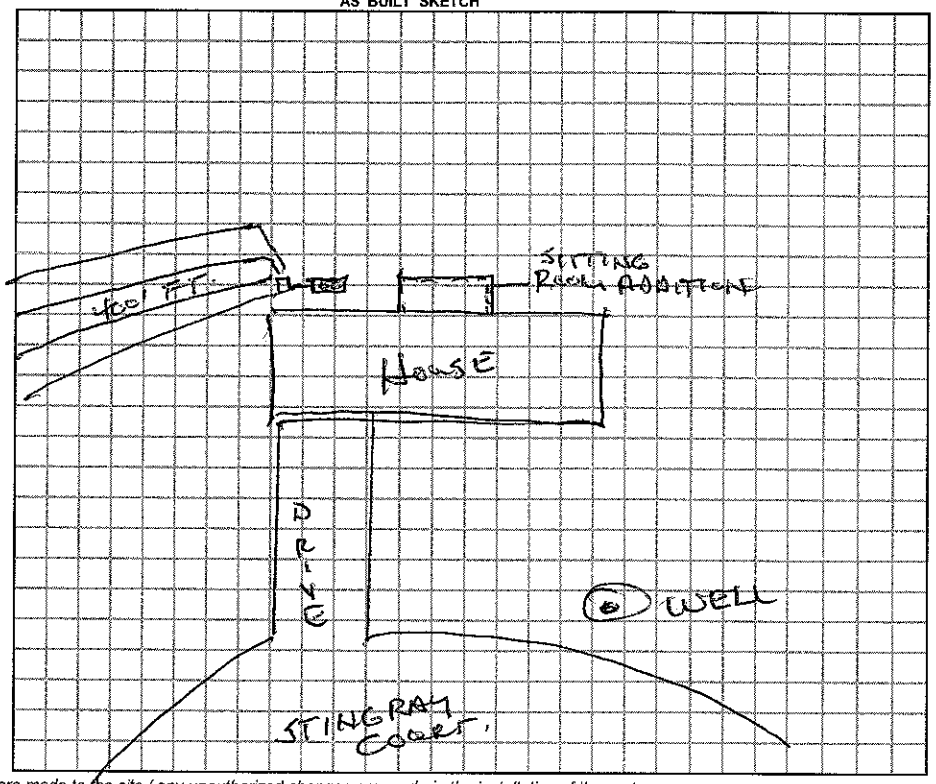

Permit can be suspended or revoked if any false information is supplied toward securing the permit / any unauthorized changes are made to the site / any unauthorized changes are made in the installation of the system.

☐ *IMPROVEMENT PERMIT w / plat valid without expiration.* ☐ *IMPROVEMENT PERMIT w / site plan valid for 60 mos.* ☐ *AUTHORIZATION TO CONSTRUCT valid for period equal to IMPROVEMENT PERMIT-not to exceed 60 mo.*

Owner / Applicant Signature: _____ Date _____

Improvement Permit by: _____ Date _____

Authorzation to Construct by: _____ Date _____

YOU SHOULD CONTACT A LOCATOR SERVICE PRIOR TO ANY EXCAVATION.

Installed by: _____

Operation Permit by: _____ Date: _____

Existing System Inspected by: Wesley Sparkman Date: 7/24/09

WHITE COPY Environmental Health YELLOW COPY (Final) Owner / Applicant PINK COPY (Initial) Owner / Applicant