IREDELL COUNTY HEALTH DEPARTMENT

STATESVILLE 704-878-5305 MOORESVILLE 704-664-5281

IMPROVEMENT PERMIT / AUTHORIZATION TO CONSTRUCT / OPERATION PERMIT / EXISTING SYSTEM INSPECTION

PERMIT # 159501 PIN # 4624-97-7239 DATE 1-11-10

OWNER or APPLICANT [redacted] PAUL SCHWARTZOTT PHONE: Business 704-799-3929 Home:

OWNER or APPLICANT ADDRESS 470 N. BROAD ST. SUITE D (APP.)

LOCATION / DIRECTIONS BSR, TL YACHT, C END ON L

SUBDIVISION MECK-NECK BLOCK / SECTION LOT # 21 LOT AREA .789Ac DESIGN FLOW 480 GPD L.T.A.R. .3

Septic Tank 1000 Gallons: STB 794 Date 3-10-10
Pump Tank 1000 Gallons: PT 283 Date 8-13-10
Pump Make Gouds Model WE0.312 Serial #
Nitrification Field No Fields 1 No Lines 4 Linear Feet 295'
Trench Width 24-36" Max. Trench Bottom Depth 36" Gravel Depth —


☒ New System ☐ Repair ☐ Expansion System Type I II III (IV) V VI
System Description: LP- PANEL BLOCK
Repair System Description: LP- PANEL BLOCK
Maintenance Agreement Required ☒ YES ☐ NO
☐ GRAVITY ☒ PRESSURE

☒ Residence No. Bedrooms 4
☐ Business No. Persons 8
☐ Other No. Employees
☐ Slab ☒ Crawl Space
☐ Basement w/plumbing ☐ Basement w/o plumbing

Water Supply: ☒ Private ☐ Public ☐ Community


Comments / Conditions 1) REFER TO APPROVED PLAN FROM ROLLANS SOIL + ENVIRONMENTAL SER. 2) POOL AREA COULD BE CHANGED OR ELIMENATED DUE TO PENDING WELL VARIANCE APP. WITH NCDENR 3) WELL IN DRAINFIELD MUST BE

INITIAL SITE SKETCH

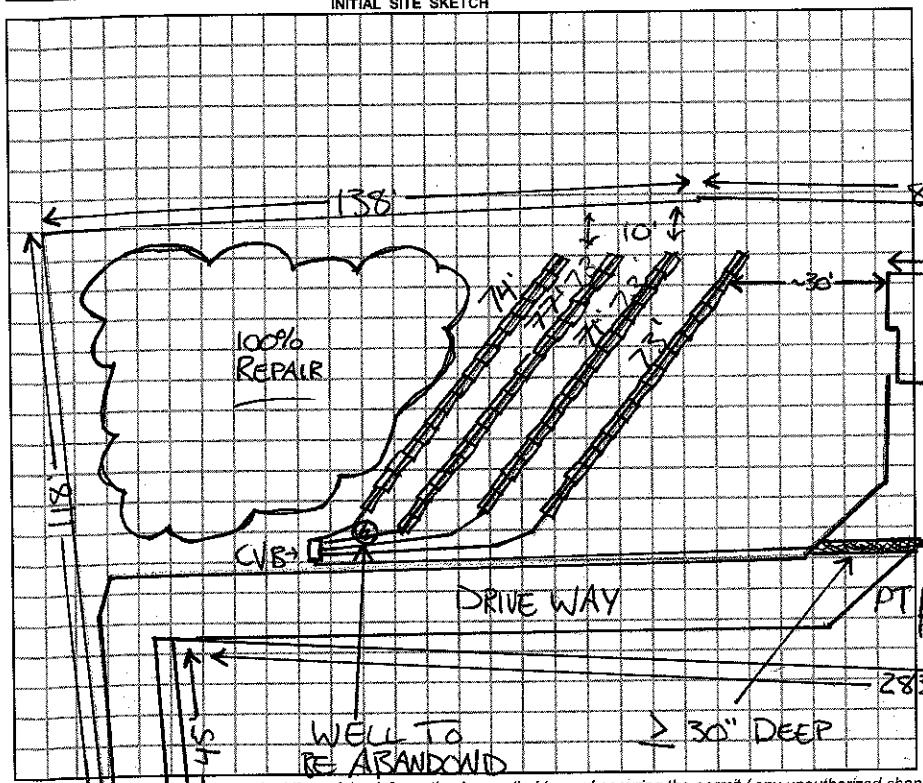

Comments / Conditions ABANDOND BEFORE AC IS ISSUED ~12" of Drainfield Soil was compacted due to parking on top. ST 10ft off House & 10ft off PT. ST & Drainfield Checked 9/23/10 Pressure, Float & Alarm Checked 12/3/10

AS BUILT SKETCH

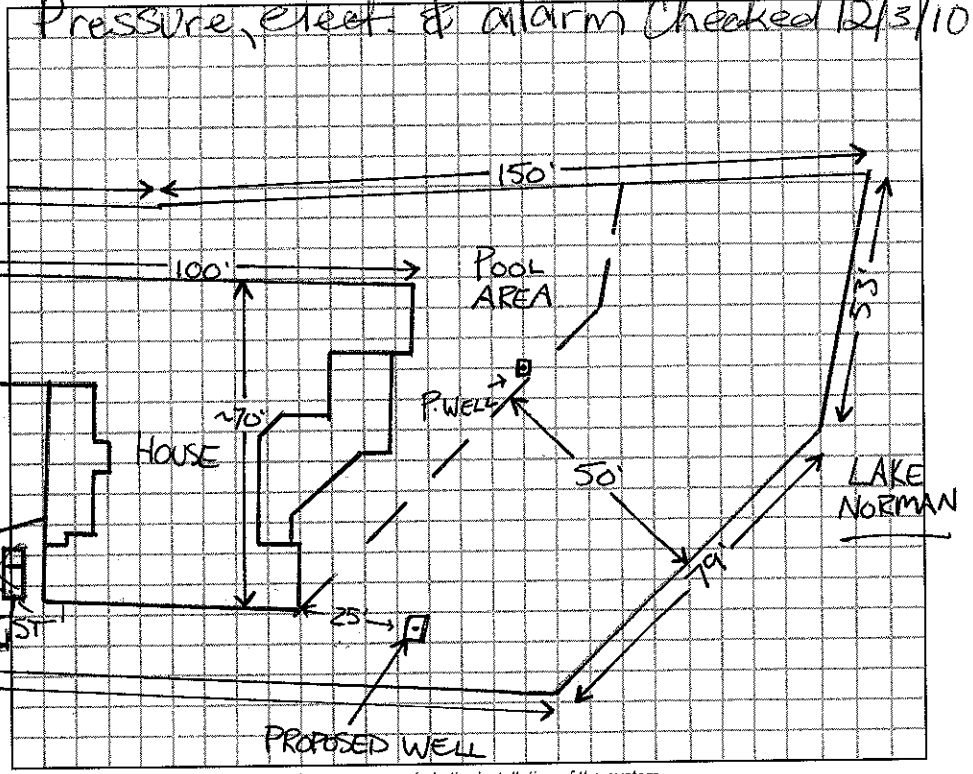

Permit can be suspended or revoked if any false information is supplied toward securing the permit / any unauthorized changes are made to the site / any unauthorized changes are made in the installation of the system.

☐ IMPROVEMENT PERMIT w / plat valid without expiration ☒ IMPROVEMENT PERMIT w / site plan valid for 60 mos. ☐ AUTHORIZATION TO CONSTRUCT valid for period equal to IMPROVEMENT PERMIT-not to exceed 60 mo.

Owner / Applicant Signature: [redacted] Date 1/13/10

Improvement Permit by: [redacted] REHS Date 1-12-10

Authorzation to Construct by: [redacted] REHS Date 4-19-10

YOU SHOULD CONTACT A LOCATOR SERVICE PRIOR TO ANY EXCAVATION.

Installed by: [redacted] REHS

Operation Permit by: [redacted] Date: 12/3/2010

Existing System Inspected by: [redacted] Date:

WHITE COPY Environmental Health YELLOW COPY (Final) Owner / Applicant PINK COPY (Initial) Owner / Applicant