3:30

IREDELL COUNTY HEALTH DEPARTMENT

↓ AUTHORIZATION TO CONSTRUCT

STATESVILLE 704-878-5305 MOORESVILLE 704-664-5281

IMPROVEMENT PERMIT / ~~CERTIFICATE OF COMPLETION~~ / OPERATION PERMIT / EXISTING SYSTEM INSPECTION

PROPERTY DESCRIPTION NO. 26293 DATE 4/7/97 TAX MAP NO. 4624982126 Watershed: ☑ Yes ☐ No

OWNER OR CONTRACTOR JEFF FREUND PHONE: Business _____ Home 663-7768

ADDRESS 120 SPINNAKER CT. DAVIDSON NC 28036

LOCATION BRAWLEY SCHOOL RD - TL YACHT RD - CORNER OF LIVINGSTON, YACHT, AND PELICAN RD

SUBDIVISION WILLIAMS PT BLOCK / SECTION _____ LOT 19 LOT AREA ≈1.5AC SITE CLASS. PS DESIGN FLOW 360GPD L.T.A.R. .36GPD/FT²

Septic Tank: 1000 Gallons; STB 794 Date 4/21/97

Pump Tank: _____ Gallons; PT _____ Date _____

Pump Make: _____ Model _____ Serial No. _____

Nitrification Field: No Fields 1 Square Feet 900 Linear Feet 300

No Lines 5@60' Trench Width 36" Max Trench Bottom Depth 36" Gravel Depth N/A

☑ New System ☐ Repair System Type: I, II, III, IV, V, VI

System Description: GRAVITY CHAMBERED

Repair System Description: GRAVITY PANEL

Maintenance Agreement Required: ☐ Yes ☑ No

☑ House/Mod. Home No. Bedrooms 3

☐ Mobile Home No. Bathrooms 2

☐ Business No. Employees _____

☐ Other _____


☐ Slab ☑ Crawl Space ☐ Basement w/plumbing ☐ Basement wo/plumbing

Water Supply: ☑ Individual ☐ Community ☐ Public

Comments: Tanks & lines inspected 11/5/97. MO

Comments:

INITIAL SITE SKETCH

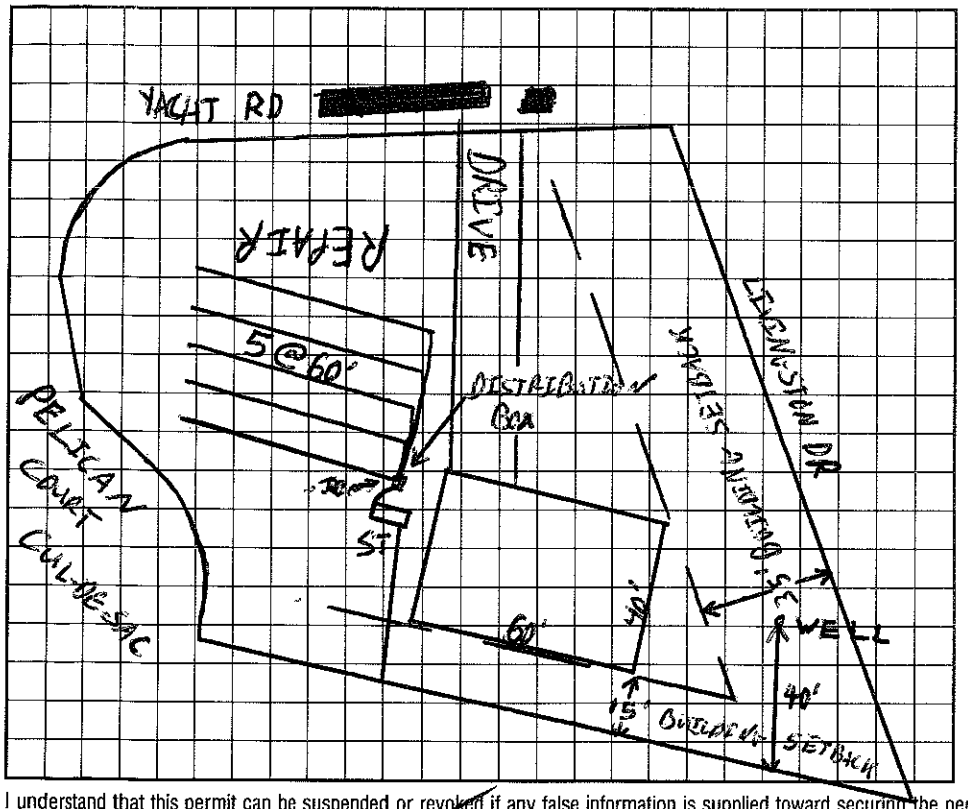

AS BUILT SKETCH

I understand that this permit can be suspended or revoked if any false information is supplied toward securing the permit/any unauthorized changes are made to the site/any unauthorized changes are made in the installation of the system. Improvement Permit is valid for 60 months from date of issuance.

Signed: _____

Improvement Permit by: _____ date 4/7/97

Existing System Inspection by: _____ date 4/7/97

Installed by: Big M Construction

Certificate of Completion by: _____ date _____

Operation Permit by: _____ date 11/6/97

HEALTH DEPT. COPY: WHITE INSPECTION COPY (FINAL): GREEN OWNER COPY (FINAL): YELLOW INSPECTION COPY (INITIAL): PINK OWNER COPY (INITIAL): GOLD