IREDELL COUNTY HEALTH DEPARTMENT

STATESVILLE 704-878-5305 MOORESVILLE 704-664-5281

IMPROVEMENT PERMIT / AUTHORIZATION TO CONSTRUCT / OPERATION PERMIT / EXISTING SYSTEM INSPECTION

$175.00 Paid 2:00

PERMIT# 103781 PIN# 4624986155 DATE 12-27-01

OWNER OR CONTRACTOR Tammy Isenhour PHONE: Business (704) 905-2474 Cell Home (704) 875-5725*

ADDRESS 104 Wellcraft Ct. Mooresville, NC 28117 Craig Roseman 534-1499 664-9500

LOCATION Brawley School Rd TL Yacht Rd go ~ 1 mi TL Livingstone Ln TR Melville Ct 2nd on left

SUBDIVISION Lk. Norman Yacht Club BLOCK / SECTION ____ LOT 2 LOT AREA .54 Acre SITE CLASS. PSJ DESIGN FLOW 360 gpd L.T.A.R. .37

Septic Tank: 1000 Gallons; STB 794 Date 3-22-03
Pump Tank: 1000 Gallons; PT 283 Date 7-26-03
Pump Make: Liberty Model ~~280~~ 283 Serial No. 27917
Nitrification Field: No Fields 1 Square Feet 900' Linear Feet 300'
No Lines 5 @ 60' Trench Width 36" Max Trench Bottom Depth 36" Gravel Depth N/A

X New System ☐ Repair System Type: I, II, III, IV, V, VI
System Description: Pump - 25% Reduction
Repair System Description: Panel (LP) Block/Pump
Maintenance Agreement Required: ☐ Yes X No


X House/Mod. Home ☐ Mobile Home ☐ Business ☐ Other
No. Bedrooms 3 No. Bathrooms 3 No. Employees ____
☐ Slab X Crawl Space ☐ Basement w/plumbing ☐ Basement wo/plumbing

Water Supply: X Individual ☐ Public ☐ Community


Comments/Conditions: Keep Septic System 10' from PL, 50' from lake & at least 50' from any well. Keep drainlines 15' from ditch (>2ft cut)

Comments/Conditions: Checked tanks, lines & pressure Elect & alarm 9/11/03 by WS

Scale 1:40 INITIAL SITE SKETCH

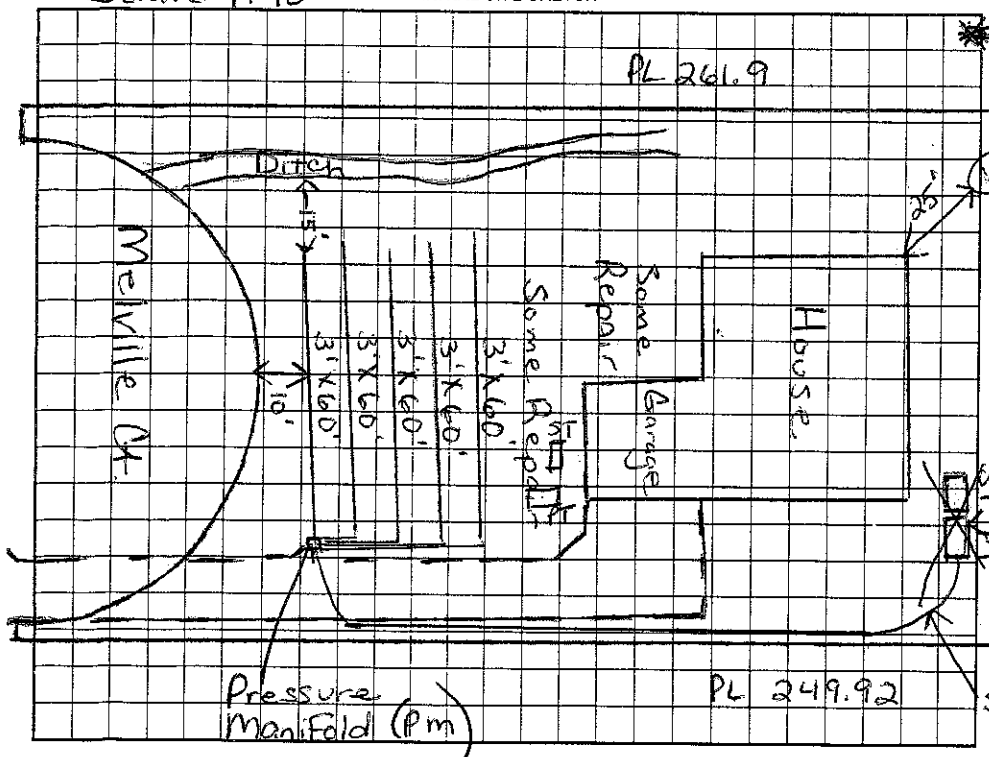

AS BUILT SKETCH

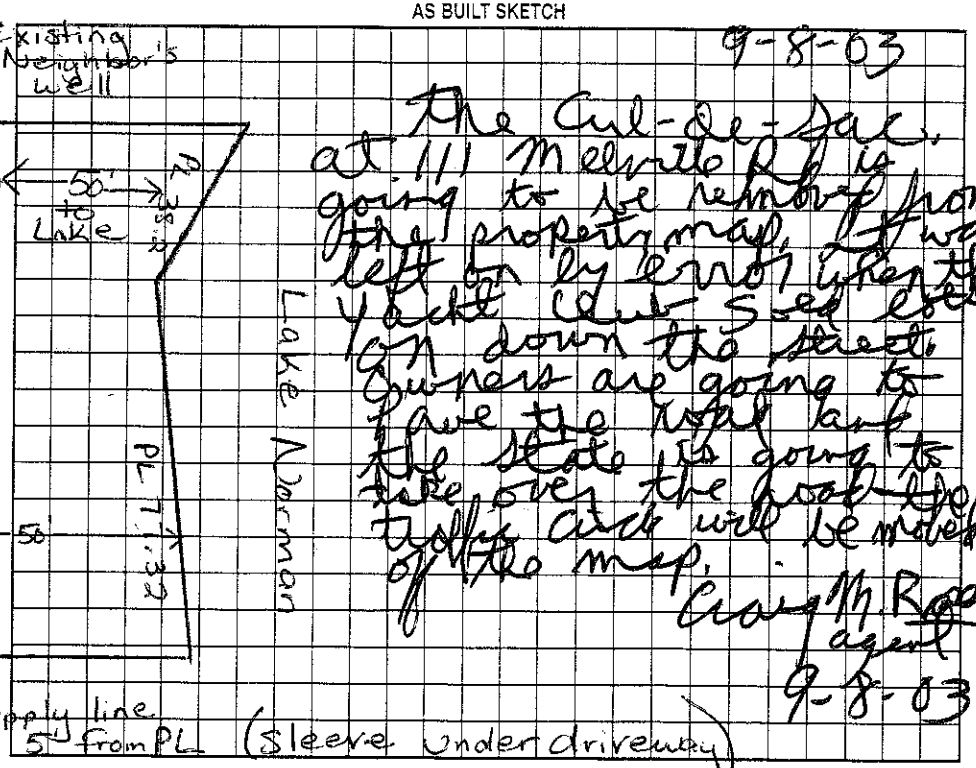

9-8-03
The Cul-de-Sac at 111 Melville Ct is going to be removed from the property map. It was left on by error when the Yacht Club Sub Div was laid down the street. Owners are going to have the road taken by the state so going to take over the road. The traffic circle will be moved off the map.
Craig M. Roseman Agent
9-8-03

Permit can be suspended or revoked if any false information is supplied toward securing the permit/any unauthorized changes are made to the site/any unauthorized changes are made in the installation of the system. Improvement Permit with plat valid without expiration. Improvement Permit with site plan valid for sixty months. Authorization to Construct is valid for a period equal to that of Improvement Permit – not to exceed sixty months.

Signed: [signature] RS date 1/28/02 Installed by: Little's Landscape

Improvement Permit by: Maina M. Dotson RS date 1/11/02 Operation Permit by: Maina M. Dotson RS date 9/12/03

Authorization to Construct by: Maina M. Dotson RS date 1/11/02 Existing System Inspection by: ____ date ____

HEALTH DEPT. COPY: WHITE OWNER COPY (FINAL): YELLOW OWNER COPY (INITIAL): PINK