IREDELL COUNTY HEALTH DEPARTMENT

STATESVILLE 704-878-5305 MOORESVILLE 704-664-5281

IMPROVEMENT PERMIT / AUTHORIZATION TO CONSTRUCT / OPERATION PERMIT / EXISTING SYSTEM INSPECTION

PERMIT # REPAIR PIN # 4624-99-0401 DATE 2-25-11

OWNER or APPLICANT JEROD LENTZ PHONE: Business 704-902-4602 Home:

OWNER or APPLICANT ADDRESS

LOCATION / DIRECTIONS RSR, YACHT RD, TL @ YACHT CLUB, TL, ON R

SUBDIVISION LAKE N. YACHT CLUB BLOCK / SECTION LOT # LOT AREA DESIGN FLOW L.T.A.R.

Septic Tank 1000 Gallons: STB 760 Date 12-6-10
Pump Tank Gallons: P T Date
Pump Make Model Serial #
Nitrification Field No Fields No Lines Linear Feet EXISTING
Trench Width Max. Trench Bottom Depth Gravel Depth

☐ New System ☒ Repair ☐ Expansion System Type I II III IV V VI
System Description: REPLACE TANK
Repair System Description:
Maintenance Agreement Required ☐ YES ☒ NO
☒ GRAVITY ☐ PRESSURE


☐ Residence No. Bedrooms
☐ Business No. Persons
☒ Other No. Employees
☒ Slab ☐ Crawl Space
☐ Basement w/plumbing ☐ Basement w/o plumbing
BATH HOUSE

Water Supply
☒ Private
☐ Public
☐ Community


Comments / Conditions - PUMP, CRUSH & FILL OLD TANK
- MIN 50' SETBACK TO WELL

Comments / Conditions INSTALLED AS SHOWN - D BOX STOPPED UP WITH SOLIDS. LENTZ CLEANED OUT. BA

INITIAL SITE SKETCH

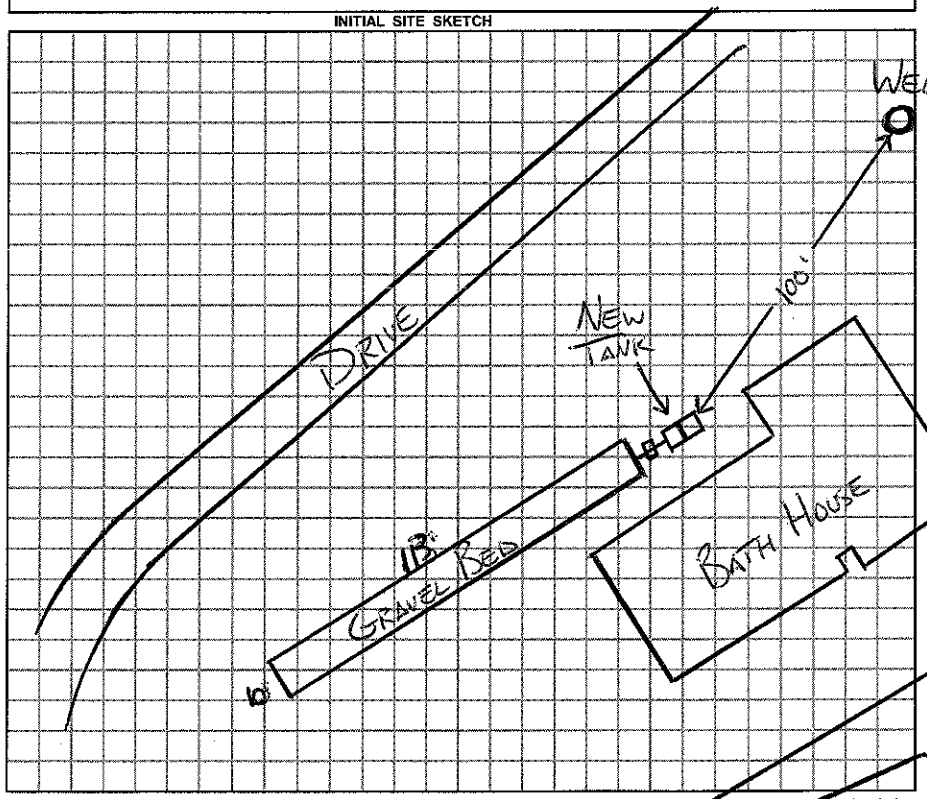

AS BUILT SKETCH

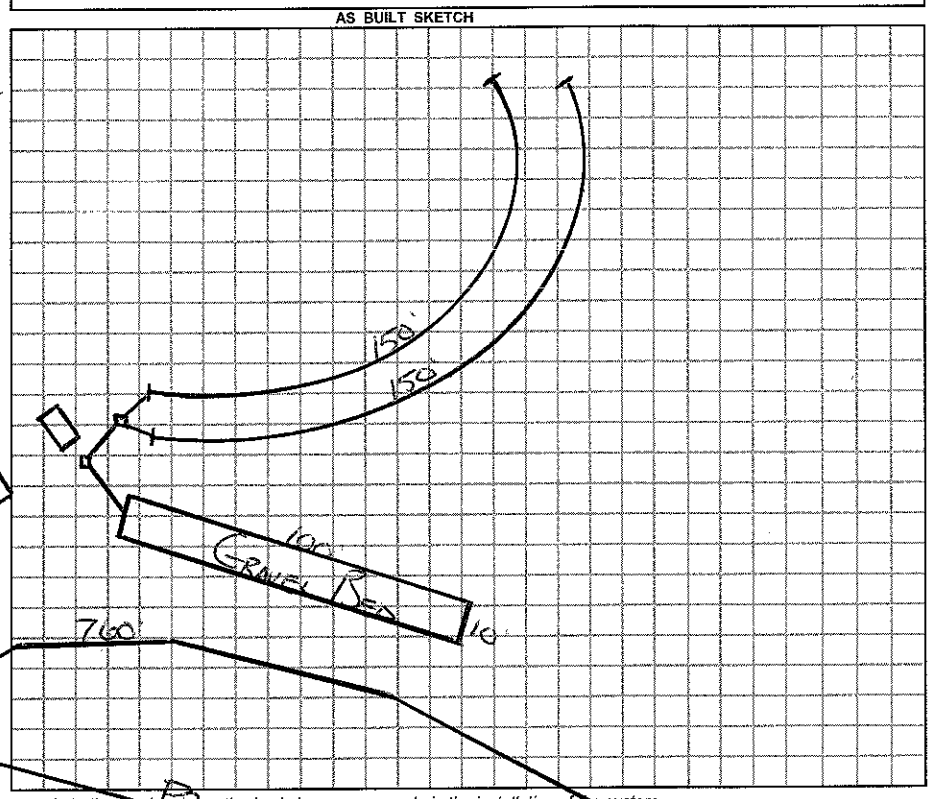

Permit can be suspended or revoked if any false information is supplied toward securing the permit / any unauthorized changes are made to the site / any unauthorized changes are made in the installation of the system.

☐ *IMPROVEMENT PERMIT w / plat valid without expiration.* ☐ *IMPROVEMENT PERMIT w / site plan valid for 60 mos.* ☐ *AUTHORIZATION TO CONSTRUCT valid for period equal to IMPROVEMENT PERMIT-not to exceed 60 mo.*

Owner / Applicant Signature: Date 3-2-11

Improvement Permit by: Date 2-25-11

Authorzation to Construct by: REMS Date 2-25-11

Installed by: LENTZ

Operation Permit by: REMS Date: 3-3-11

Existing System Inspected by: Date:

YOU SHOULD CONTACT A LOCATOR SERVICE PRIOR TO ANY EXCAVATION.

WHITE COPY Environmental Health YELLOW COPY (Final) Owner / Applicant PINK COPY (Initial) Owner / Applicant

LKN

IREDELL COUNTY HEALTH DEPARTMENT

Statesville Phone TR 3-7271 Mooresville Phone NO 3-1271

PERMIT TO INSTALL SEPTIC TANK

Permit No. 138 Permit Date 7-21- 1972

Owner Lake Norman Yacht club Address Mooresville

Installed By Raymond Adams Address Hiddnitte


Location of Property 1100 to 1182 at end of Road At Rec Area

Tank		Capacity		Length of Lines		Fixtures	
Block	( )	1000	( )	225'	( )	No. of Baths	( )
Precast	( )	1250	( )	250'	( )	Dishwasher	( )
		1500	( )	Other 450'		Garbage Grdr.	( )
		Other				Other	

NOTIFY HEALTH DEPARTMENT AT LEAST EIGHT HOURS BEFORE TANK IS TO BE INSPECTED.

Final Inspection 19 Approved ( ) Disapproved ( )

Remarks Repair

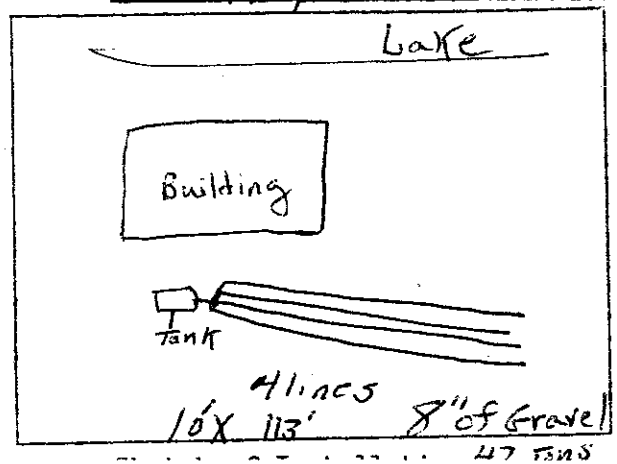

check on Friday but not quite finished. He finished it on Saturday

Sanitarian