IREDELL COUNTY HEALTH DEPARTMENT

STATESVILLE 704-878-5305 MOORESVILLE 704-664-5281

IMPROVEMENT PERMIT / CERTIFICATE OF COMPLETION / OPERATION PERMIT / EXISTING SYSTEM INSPECTION

PROPERTY DESCRIPTION NO. 21357 DATE 7/5/95 TAX MAP NO. 2P-1-A 210 Watershed: X Yes ☐ No

OWNER OR CONTRACTOR Jack M Kreckmen PHONE: Business Home 716-594-2219

ADDRESS 7 Sunny side Ln. N. Chili NY 14514 4625-00-0450

LOCATION Stonemarker, straight on (L) after 4th house

SUBDIVISION Stonemarker BLOCK / SECTION LOT 32 LOT AREA ~1 AC SITE CLASS. P DESIGN FLOW 360 L.T.A.R. .35

Septic Tank: 1000 Gallons; STB 1012 Date 9/12/95

Pump Tank: Gallons; PT Date

Pump Make: Model Serial No.

Nitrification Field: No Fields 1 Square Feet 1028 Linear Feet ~~259~~ (342)

No Lines 3 Trench Width 36" Max Trench Bottom Depth 36" Gravel Depth N/A

X New System ☐ Repair System Type: I, II, (III) IV, V, VI

System Description: GRAVITY - INFILTRATOR

Repair System Description: SAME

Maintenance Agreement Required: ☐ Yes X No

X House/Mod. Home ☐ Mobile Home ☐ Business ☐ Other

No. Bedrooms 3 No. Bathrooms 2 No. Employees


☐ Slab X Crawl Space ☐ Basement w/plumbing ☐ Basement wo/plumbing

Water Supply: X Individual ☐ Community ☐ Public


Comments: X 25% reduction for use of Infiltrator drainfield materials

Comments:

INITIAL SITE SKETCH

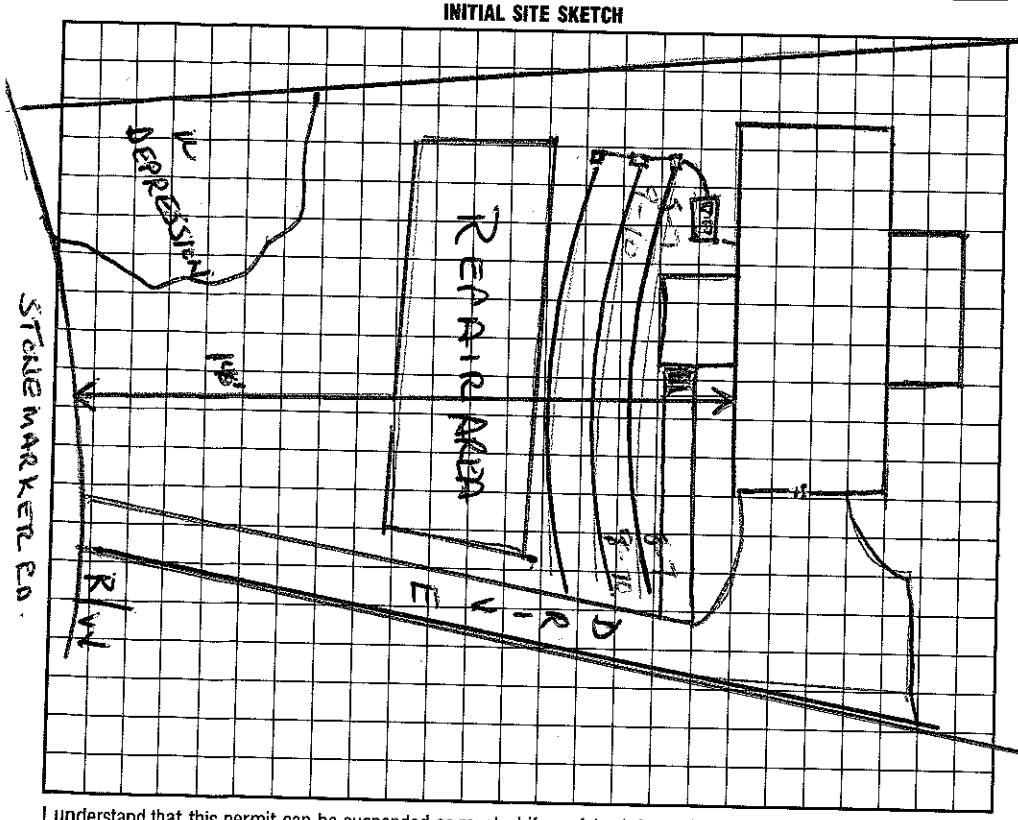

AS BUILT SKETCH

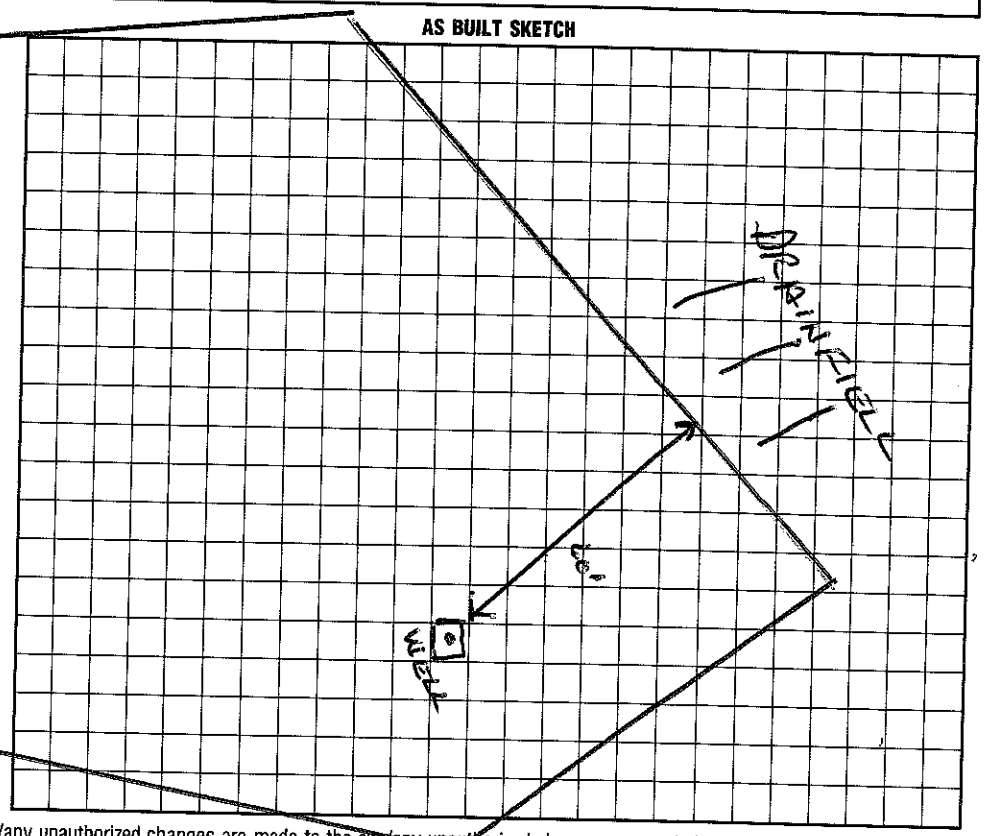

I understand that this permit can be suspended or revoked if any false information is supplied toward securing the permit/any unauthorized changes are made to the site/any unauthorized changes are made in the installation of the system. Improvement Permit is valid for 60 months from date of issuance.

Signed:

Improvement Permit by: Wesley Sparks date 7/5/95

Existing System Inspection by: date

Installed by: Tommy Frye

Certificate of Completion by: Wesley Sparks RS date 12/4/95

Operation Permit by: Wesley Sparks RS date 12/4/95

HEALTH DEPT. COPY: WHITE INSPECTION COPY (FINAL): GREEN OWNER COPY (FINAL): YELLOW INSPECTION COPY (INITIAL): PINK OWNER COPY (INITIAL): GOLD