IREDELL COUNTY HEALTH DEPARTMENT

STATESVILLE 704-878-5305 MOORESVILLE 704-664-5281

IMPROVEMENT PERMIT / AUTHORIZATION TO CONSTRUCT / OPERATION PERMIT / EXISTING SYSTEM INSPECTION

PERMIT# 137603 PIN# 4625000674 DATE 8-31-06

OWNER OR APPLICANT Quest Custom Homes Inc PHONE: Business 704 400-4358 Home

ADDRESS ~~Box~~ P.O. Box 3562 Mooresville, NC 28117

LOCATION Brawley School TR Stone marker on left near intersection with Clematis

SUBDIVISION Stonemarker BLOCK / SECTION LOT 30 LOT AREA .962 Acre SITE CLASS. PS DESIGN FLOW 480gpd L.T.A.R. .3

Septic Tank: 1000 Gallons; STB 10:2 Date 9/11/06
Pump Tank: Gallons; PT Date
Pump Make: Model Serial No.
Nitrification Field: No Fields 1 Square Feet 1200' Linear Feet 460'
No Lines 4@100 Trench Width 36" Max Trench Bottom Depth 36"

[X] New System [ ] Repair [ ] Expansion System Type: I II III IV V VI
System Description: Gravity - 25% Reduction
Repair System Description: Gravity - 25% to 50% Reduction
Maintenance Agreement Required: [ ] Yes [X] No

[X] House/Mod. Home No. Bedrooms 4
[ ] Mobile Home No. Persons
[ ] Business No. Employees
[ ] Other

Water Supply: [X] Individual [ ] Public [ ] Community


Gravel Depth N/A [X] Gravity [ ] Pressure [ ] Slab [X] Crawl Space [ ] Basement w/plumbing [ ] Basement wo/plumbing

Comments:/Conditions: Keep house at least 100' from Front PL


Scale 1:50

Comments:/Conditions:
Lot topo changed before installer came on lot
- Bldr installed top line ~44" trench bottom
- soils were suitable to 56"

INITIAL SITE SKETCH

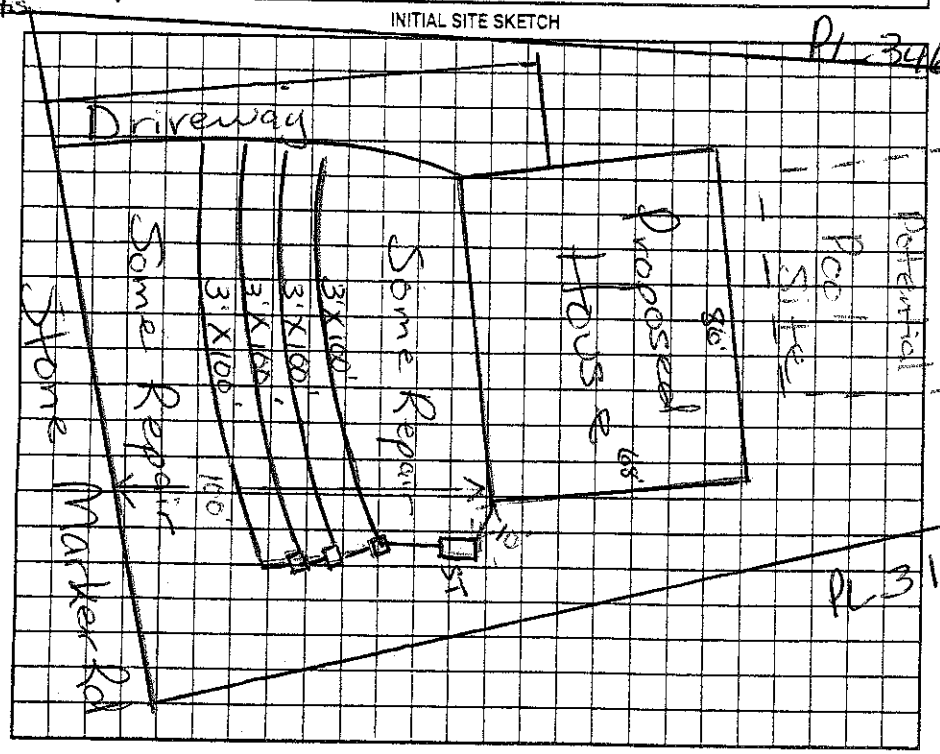

AS BUILT SKETCH

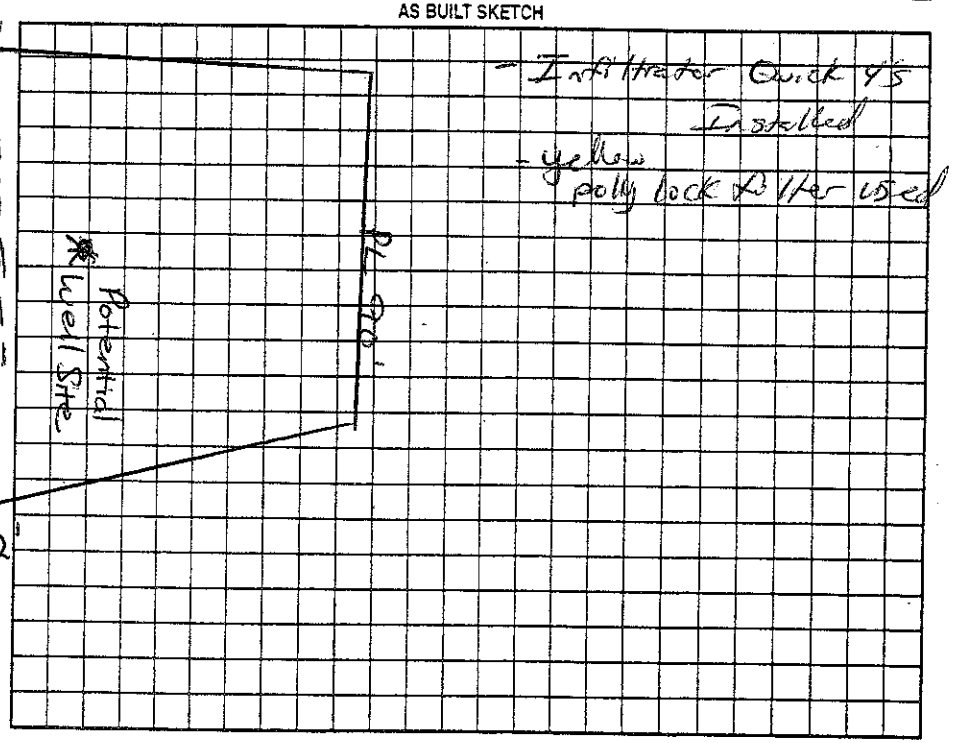

Permit can be suspended or revoked if any false information is supplied toward securing the permit/any unauthorized changes are made to the site/any unauthorized changes are made in the installation of the system. Improvement Permit with plat valid without expiration [X] Improvement Permit with site plan valid for sixty months [ ] Authorization to Construct is valid for a period equal to that of Improvement Permit – not to exceed sixty months.

Signed: date 9/1/06

Improvement Permit by: Marie H. Dotson RS date 9/1/06

Authorization to Construct by: Marie H. Dotson RS date 9/1/06

Installed by: Tommy Frye

Operation Permit by: date 3/5/07

Existing System Inspection by: date

HEALTH DEPT. COPY: WHITE OWNER COPY (FINAL): YELLOW OWNER COPY (INITIAL): PINK