IREDELL COUNTY HEALTH DEPARTMENT

Authorization to Construct

1:00

STATESVILLE 704-878-5305 MOORESVILLE 704-664-5281

IMPROVEMENT PERMIT / ~~CERTIFICATE OF COMPLETION~~ / OPERATION PERMIT / EXISTING SYSTEM INSPECTION

PROPERTY DESCRIPTION NO. 26274 DATE 3/12/97 TAX MAP NO. 4625-00-07.38 Watershed: [X] Yes [ ] No

OWNER OR CONTRACTOR Patricia Peterson PHONE: Business _____ Home 399-1143

ADDRESS 7331 Pawtucket Rd, Charlotte, NC. 28214

LOCATION E. Stonemarker Rd, Brunch TR Stonemarker straight, .5 mile on (L) past Blenney Rd.

SUBDIVISION Stonemarker BLOCK / SECTION _____ LOT 29 LOT AREA 1.01 AC SITE CLASS. PS DESIGN FLOW 240 L.T.A.R. .3

Septic Tank: 1000 Gallons; STB 794 Date 3/21/97

Pump Tank: _____ Gallons; PT _____ Date _____

Pump Make: _____ Model _____ Serial No. _____

Nitrification Field: No Fields 1 Square Feet 800 Linear Feet 280

No Lines 4 Trench Width 36" Max Trench Bottom Depth 36" Gravel Depth 12"

[X] New System [ ] Repair System Type: I, [II], III, IV, V, VI

System Description: CONVENTIONAL - DIST BOX

Repair System Description: SAME

Maintenance Agreement Required: [ ] Yes [ ] No

[X] House/Mod. Home No. Bedrooms 2

[ ] Mobile Home No. Bathrooms 1

[ ] Business No. Employees _____

[ ] Other _____


[ ] Slab [ ] Crawl Space [X] Basement w/plumbing [ ] Basement wo/plumbing

Water Supply: [X] Individual [ ] Community [ ] Public


Comments:

Comments:

INITIAL SITE SKETCH

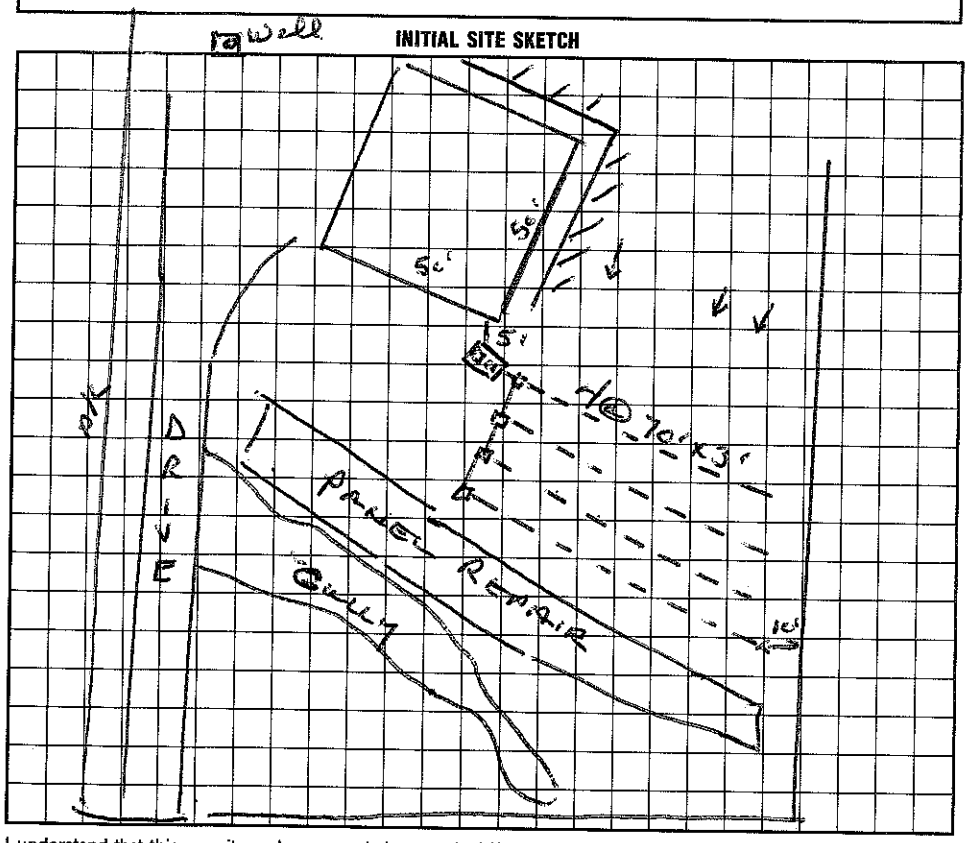

AS BUILT SKETCH

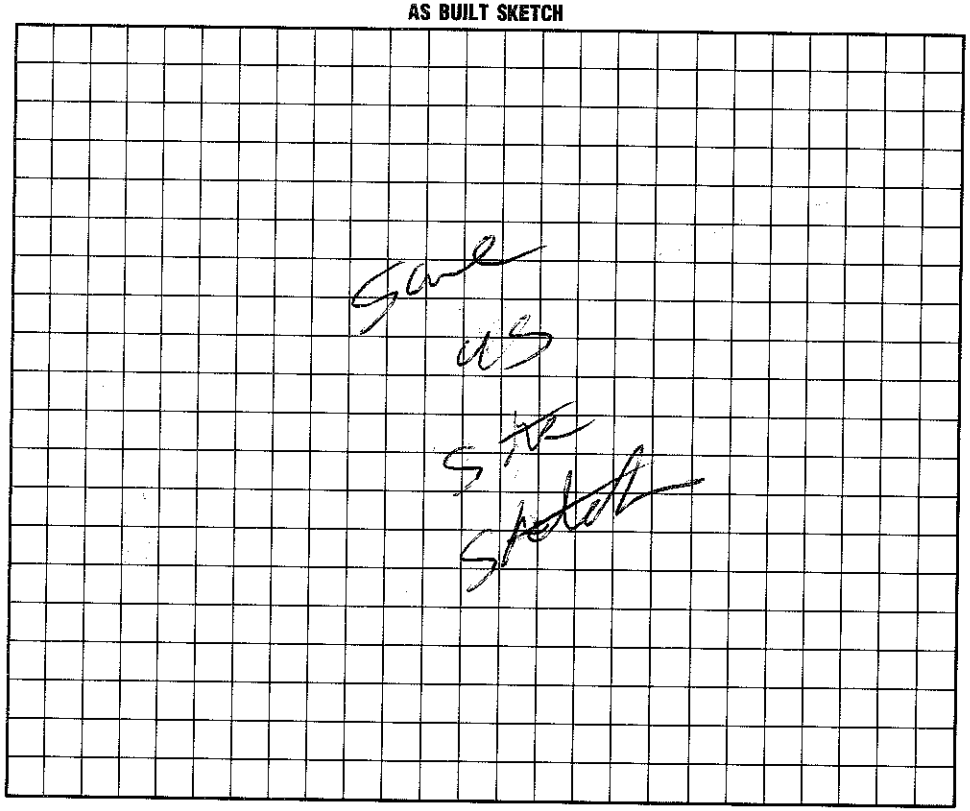

I understand that this permit can be suspended or revoked if any false information is supplied toward securing the permit/any unauthorized changes are made to the site/any unauthorized changes are made in the installation of the system. Improvement Permit is valid for 60 months from date of issuance.

Signed: Robert T. Ramey

Improvement Permit by: Wesley Shuler R.S. date 3/12/97

Authorized Existing System Inspection by: Walter Sparks R.S. date 3/12/97

Installed by: LE HENKLE GRADING

Certificate of Completion by: _____ date _____

Operation Permit by: C. [signature] date 8/7/97

HEALTH DEPT. COPY: WHITE INSPECTION COPY (FINAL): GREEN OWNER COPY (FINAL): YELLOW INSPECTION COPY (INITIAL): PINK OWNER COPY (INITIAL): GOLD