IREDELL COUNTY HEALTH DEPARTMENT

STATESVILLE 704-878-5305 250.00 Paid MOORESVILLE 704-664-5281 10'00

IMPROVEMENT PERMIT / AUTHORIZATION TO CONSTRUCT / OPERATION PERMIT / EXISTING SYSTEM INSPECTION

PERMIT# 13201 PIN# 4625 00 3697 Cell DATE 11-7-05

OWNER OR APPLICANT Paul Medeiros PHONE: Business 603 387-9082 Home 704 664-8899

ADDRESS 350 Stonemarker Mooresville NC 28117

LOCATION Bowley School Rd TR Stonemarker on right #350 just past Clematis Place

SUBDIVISION C.A.T. BLOCK / SECTION 6 LOT 1699 LOT AREA .103 Acre SITE CLASS. UPS DESIGN FLOW 360 L.T.A.R.

Exist / Adding to exist

Septic Tank: 1000 Gallons; STB Date

Pump Tank: Gallons; PT Date

Pump Make: Model Serial No: See Note

Nitrification Field: No Fields 1 Square Feet 900 Linear Feet Total 300'

No Lines 5 Total Trench Width 36" Max Trench Bottom Depth 36" Gravel Depth 12" ☒ Gravity ☐ Pressure

☐ New System ☐ Repair ☒ Expansion System Type: I II III IV V VI

System Description: Gravity – Conventional

Repair System Description: Pump – Panel Block

Maintenance Agreement Required: ☐ Yes ☐ No

☒ House/Mod. Home ☐ Mobile Home ☐ Business ☐ Other

No. Bedrooms 3 No. Persons No. Employees


Water Supply: ☐ Individual ☐ Public ☐ Community

☐ Slab ☒ Crawl Space ☐ Basement w/plumbing ☐ Basement wo/plumbing

Comments/Conditions: ★ Note: ① Adding 45 ft drainline above existing system ② Cut back existing drainlines to 10' off addition ③ Leave as is ④ Add 40' drainline.

Comments/Conditions: Replacing drainfield that has to be cut off to accomodate set back (10ft) for addition. ★ Any question call Health Dept.

INITIAL SITE SKETCH

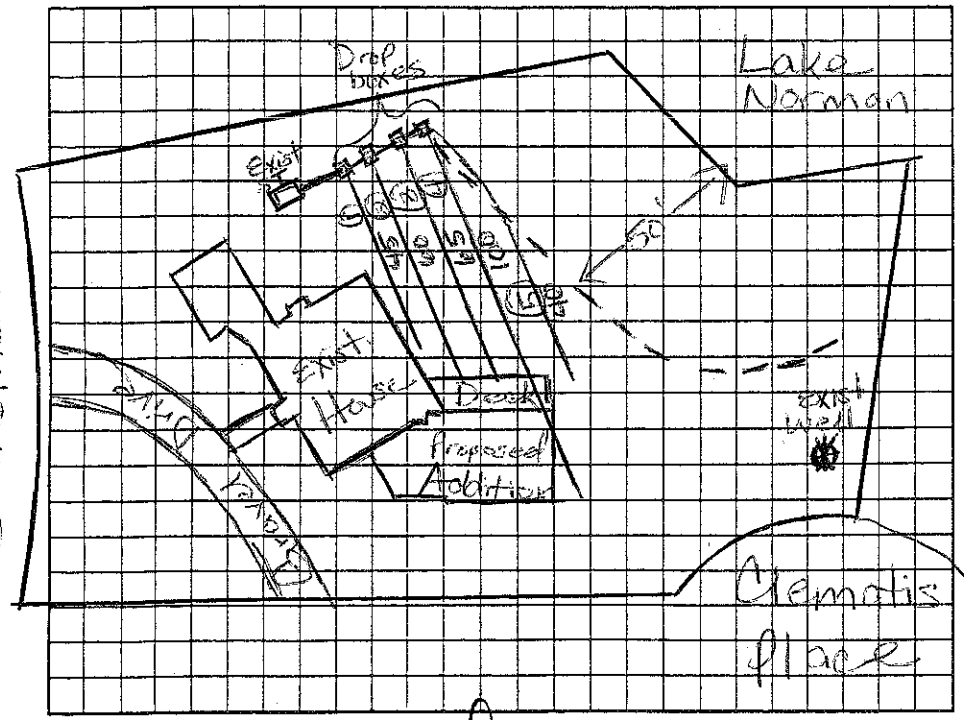

AS BUILT SKETCH

★★ Okay to use "Accepted" system for Drainfield. Installed as Drawn Used EZ Flow

Permit can be suspended or revoked if any false information is supplied toward securing the permit/any unauthorized changes are made to the site/any unauthorized changes are made in the installation of the system. Improvement Permit with plat valid without expiration ☐ Improvement Permit with site plan valid for sixty months ☐ Authorization to Construct is valid for a period equal to that of Improvement Permit – not to exceed sixty months.

Signed: D. Sullivan date 11/9/05 Installed by: R. A. Hall date

Improvement Permit by: Marian H. Dolan RS date 11/7/05 Operation Permit by: Marian H. Dolan RS date 11/18/05

Authorization to Construct by: Marian H. Dolan RS date 11/7/05 Existing System Inspection by: date

HEALTH DEPT. COPY: WHITE OWNER COPY (FINAL): YELLOW OWNER COPY (INITIAL): PINK