IREDELL COUNTY HEALTH DEPARTMENT

STATESVILLE 704-878-5305 MOORESVILLE 704-664-5281

IMPROVEMENT PERMIT / AUTHORIZATION TO CONSTRUCT / OPERATION PERMIT / EXISTING SYSTEM INSPECTION

PERMIT# 087971 PIN# 4625003697 DATE 3/20/2000

OWNER OR CONTRACTOR Audrey Mayville — Tim Loflow PHONE: Business (336) 723-8503 Tim Home (336) 723-7385

ADDRESS 350 Stonemarket Rd Mooresville, NC 28117

LOCATION Brawley School Rd to Stonemarker TR, 1/2 mile on right

SUBDIVISION CTAJT BLOCK / SECTION 6 LOT 1699 LOT AREA .63 SITE CLASS. DESIGN FLOW 360gpd T.A.R.

Septic Tank: 1000 Gallons; STB Date

Pump Tank: Gallons; PT Date

Pump Make: Model Serial No.

Nitrification Field: No Fields 1 Square Feet 900 Linear Feet 300

No Lines 3 at 100 Trench Width 36" Max Trench Bottom Depth 36" Gravel Depth 12"

☐ New System ☐ Repair System Type: I, II, III, IV, V, VI

System Description: Existing Gravity-Conventional

Repair System Description: Modified

Maintenance Agreement Required: ☐ Yes ☐ No

☒ House/Mod. Home No. Bedrooms 3

☐ Mobile Home No. Bathrooms 3

☐ Business No. Employees

☐ Other


☐ Slab ☒ Crawl Space ☐ Basement w/plumbing ☐ Basement wo/plumbing

Water Supply: ☒ Individual ☐ Public ☐ Community

Comments:/Conditions: Existing Septic System appears to be functioning OK at time of inspection, No problems Noticed

Comments:/Conditions: Septic System Okay for 3 Bedrooms. System originally installed 1-11-89 under Claude Eugene Melton.

INITIAL SITE SKETCH

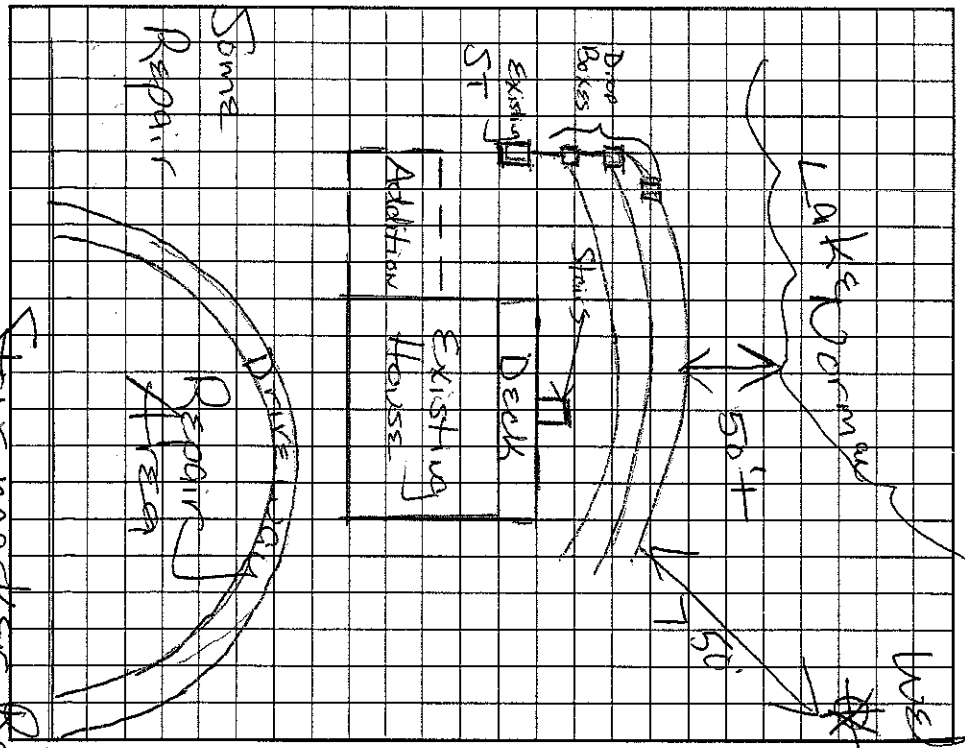

AS BUILT SKETCH

Permit can be suspended or revoked if any false information is supplied toward securing the permit/any unauthorized changes are made to the site/any unauthorized changes are made in the installation of the system. Improvement Permit with plat valid without expiration. Improvement Permit with site plan valid for sixty months. Authorization to Construct is valid for a period equal to that of Improvement Permit – not to exceed sixty months.

Signed: date 3/20/00 Installed by:

Improvement Permit by: Maria H. Dotson R.S. date 3/20/2000 Operation Permit by: date

Authorization to Construct by: date Existing System Inspection by: Maria H. Dotson R.S. date 3/20/2000

HEALTH DEPT. COPY: WHITE OWNER COPY (FINAL): YELLOW OWNER COPY (INITIAL): PINK