4625080701 11:00

IREDELL COUNTY HEALTH DEPARTMENT

STATESVILLE 704-878-5305 MOORESVILLE 704-664-5281

IMPROVEMENT PERMIT / AUTHORIZATION TO CONSTRUCT / OPERATION PERMIT / EXISTING SYSTEM INSPECTION

DATE 11/3/2000

PERMIT# 089046 PIN# ~~4625081655~~

OWNER OR CONTRACTOR Linda Martin PHONE: Business (803) 684-1928 or 216 Home (803) 684-4429

ADDRESS 6270 Campbell Rd. York, SC 29745

LOCATION Brawley School Rd. TR Chukkywood TL Barber Loop TL Old Arboraway TR Rolling Wood at end

SUBDIVISION CLAP BLOCK / SECTION 7 LOT 126 LOT AREA .82 ACRE SITE CLASS. PS DESIGN FLOW 360gpd L.T.A.R. .3

Septic Tank: 1000 Gallons; STB 794 Bellinger Date 10-27-00
Pump Tank: ____ Gallons; PT ____ Date ____
Pump Make: ____ Model ____ Serial No. ____
Nitrification Field: No Fields 1 Square Feet 900' Linear Feet 300'
No Lines 3 at 100' Trench Width 36" Max Trench Bottom Depth 36"

☒ New System ☐ Repair System Type: I, II, III, IV, V, VI
System Description: Gravity - 25% Reduction
~~Repair System Description: Pump feed Innovative~~
Maintenance Agreement Required: ☐ Yes ☒ No


☒ House/Mod. Home No. Bedrooms 3
☐ Mobile Home No. Bathrooms 2
☐ Business No. Employees ____
☐ Other ____
Gravel Depth N/A ☐ Slab ☐ Crawl Space ☐ Basement w/plumbing ☐ Basement wo/plumbing

Water Supply: ☒ Individual ☐ Public ☐ Community

Comments:/Conditions: Keep Septic System at least 10' from PL 5' from House & 50' from lake or ANY well(s)


Comments:/Conditions: Existing well will be abandoned & relocated prior to repair area being used. *Lot in existence since 1960s

INITIAL SITE SKETCH Scale 1:50

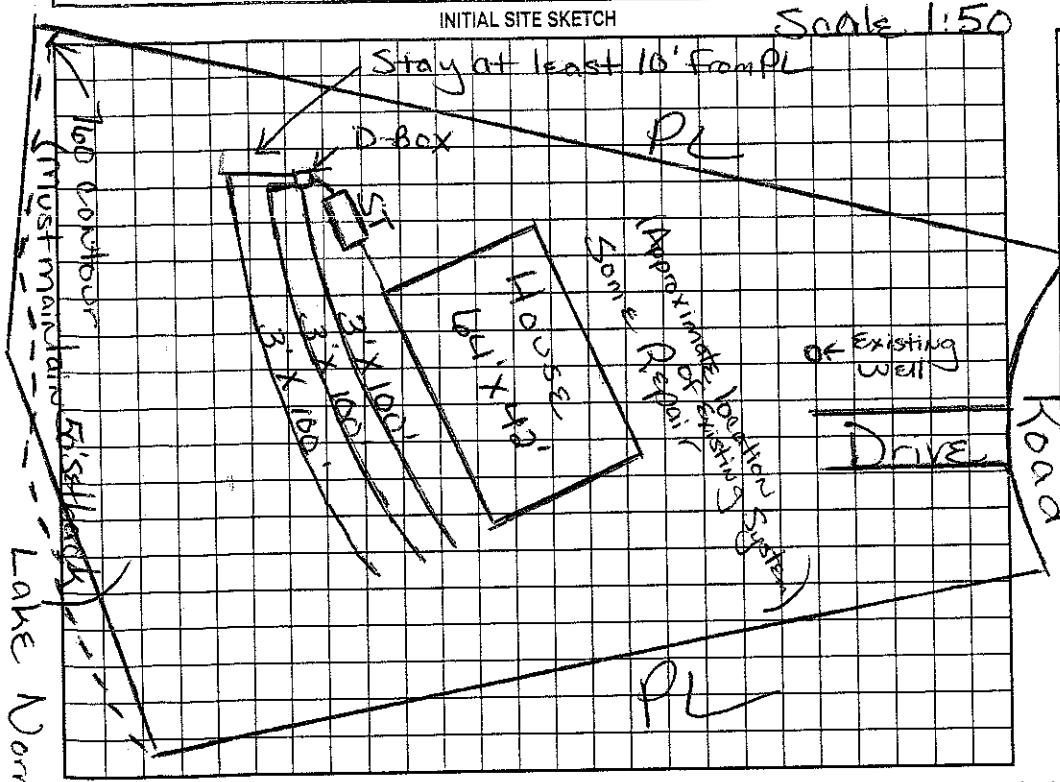

AS BUILT SKETCH

1-23-01 House was shifted towards lake approx 15' Resulting in the system being installed as shown. There is no space available for any decks. A 3' landing/steps is to be built according to the builders OK

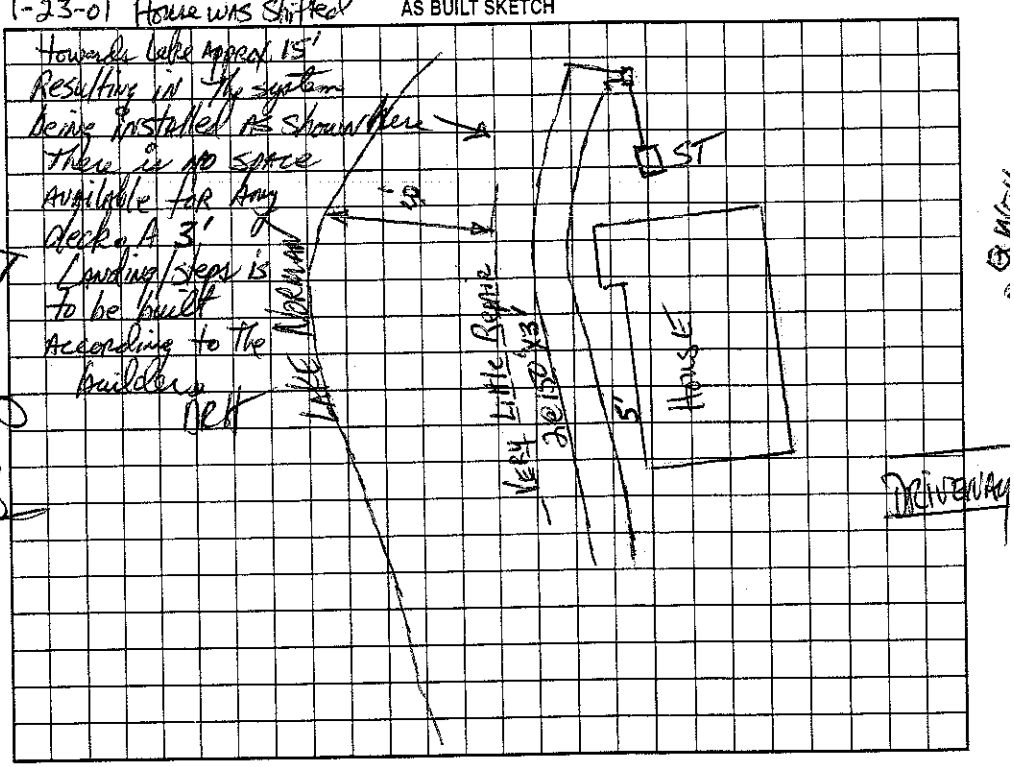

Permit can be suspended or revoked if any false information is supplied toward securing the permit/any unauthorized changes are made to the site/any unauthorized changes are made in the installation of the system. Improvement Permit with plat valid without expiration. Improvement Permit with site plan valid for sixty months. Authorization to Construct is valid for a period equal to that of Improvement Permit -- not to exceed sixty months.

Signed: Linda B. Martin date ____ Installed by: Larry Beam

Improvement Permit by: Maria H. H. Dotson R.S date 11/3/2000 Operation Permit by: ____ date 1-23-01

Authorization to Construct by: Maria H. H. Dotson R.S date 11/3/2000 Existing System Inspection by: ____ date ____

HEALTH DEPT. COPY: WHITE OWNER COPY (FINAL): YELLOW OWNER COPY (INITIAL): PINK