IREDELL COUNTY HEALTH DEPARTMENT

STATESVILLE 704-878-5305 245.00 Paid MOORESVILLE 704-664-5281

IMPROVEMENT PERMIT / AUTHORIZATION TO CONSTRUCT / OPERATION PERMIT / EXISTING SYSTEM INSPECTION

PERMIT# 12483 #4406 PIN# 4625 08 0936 DATE 1/19/05

OWNER OR CONTRACTOR Peter Schuerger (Whitley & Co) PHONE: Business 704-660-7693 Home

ADDRESS 126 Rollingwood Ln. Mooresville, NC. 28117 old

LOCATION 1100' TR Chickwood Tl Barber Loop (L) Rollingwood Ln. 2nd Rt Rollingwood Ln. on (R)

SUBDIVISION CL+T BLOCK / SECTION 7 LOT 124 LOT AREA .76ac± SITE CLASS. PS DESIGN FLOW 480 L.T.A.R. .3

Septic Tank: 1000 Gallons; STB 312 Date 12/3/04
Pump Tank: 1000 Gallons; PT 283 Date 12/4/04
Pump Make: Goulds Model WE03J2M Serial No.
Nitrification Field: No Fields 1 Square Feet 534/801 Linear Feet 267
No Lines 5@53 Trench Width 2-3' Max Trench Bottom Depth 3' Gravel Depth NA

[X] New System [ ] Repair System Type: I, II, III, [IV], V, VI
System Description: Pressured 16" PPBPS
Repair System Description: < 1983
Maintenance Agreement Required: [X] Yes [ ] No


[X] House/Mod. Home No. Bedrooms 4
[ ] Mobile Home No. Bathrooms 3
[ ] Business No. Employees
[ ] Other
[ ] Slab [ ] Crawl Space [X] Basement w/plumbing [ ] Basement wo/plumbing

Water Supply: [X] Individual [ ] Public [ ] Community


Comments:/Conditions:

Comments:/Conditions: Tanks & lines checked by WS 1/21/05
Pres Checked 2/4/05 MS
Maint. Agreement attached.

(1"=40') INITIAL SITE SKETCH

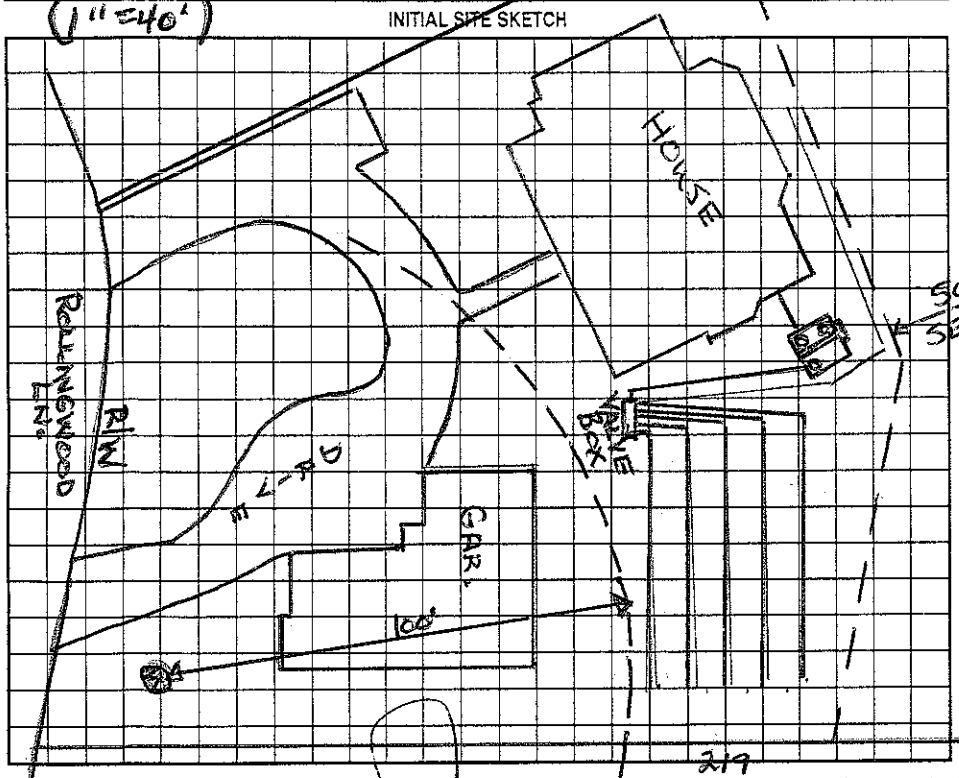

AS BUILT SKETCH

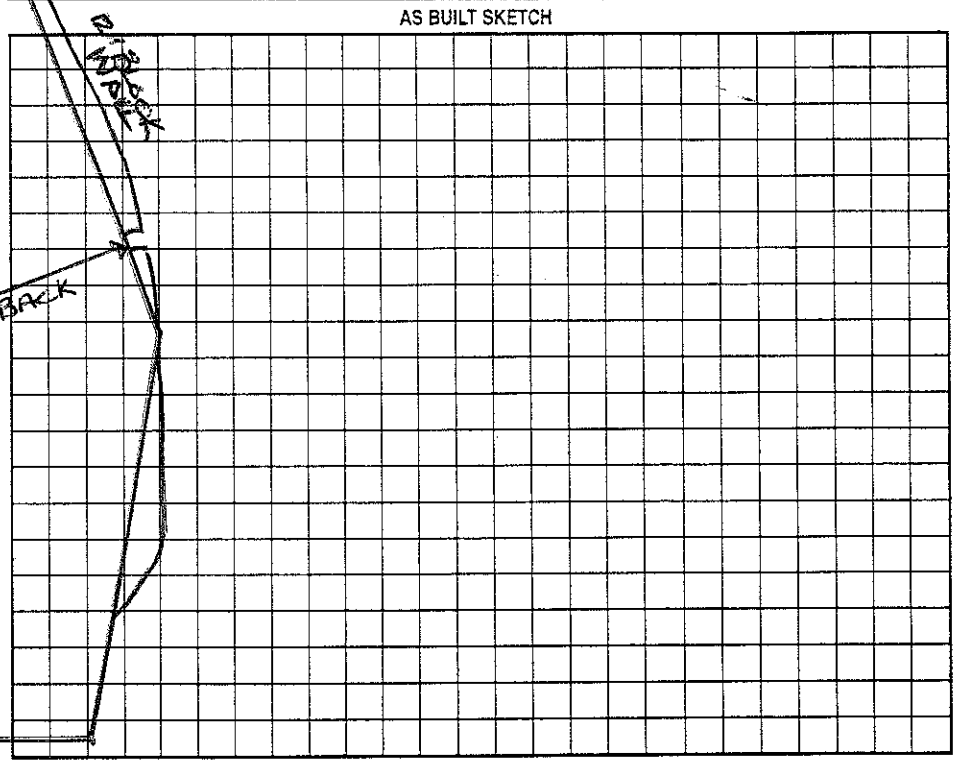

Permit can be suspended or revoked if any false information is supplied toward securing the permit/any unauthorized changes are made to the site/any unauthorized changes are made in the installation of the system. Improvement Permit with plat valid without expiration. Improvement Permit with site plan valid for sixty months. Authorization to Construct is valid for a period equal to that of Improvement Permit – not to exceed sixty months.

Signed: [signature] date 1-20-05 Installed by: Curt Dunning

Improvement Permit by: Wesley Sparks RS. date 1/19/05 Operation Permit by: [signature] RS date 3/2/05

Authorization to Construct by: Wesley Sparks RS. date 1/19/05 Existing System Inspection by: date

HEALTH DEPT. COPY: WHITE OWNER COPY (FINAL): YELLOW OWNER COPY (INITIAL): PINK