IREDELL COUNTY HEALTH DEPARTMENT

STATESVILLE 704-878-5305 MOORESVILLE 704-664-5281

IMPROVEMENT PERMIT / AUTHORIZATION TO CONSTRUCT / OPERATION PERMIT / EXISTING SYSTEM INSPECTION

PERMIT# 141762 PIN# 4625081655 DATE 5-15-07

OWNER OR APPLICANT Andrew Sipperly PHONE: Business 704-634-5909 Home 704-662-8364

ADDRESS 209 Poplar Grove Rd Mooresville

LOCATION Brawley School Rd TR chuckwood TL Barber LP TL Arborway TR Rollingwood at end

SUBDIVISION CL+T BLOCK / SECTION 7 LOT 127 LOT AREA .82 Ac SITE CLASS. PS DESIGN FLOW 600gpd L.T.A.R. .3gpd/ft²

Septic Tank: 1500 v Gallons; STB 1014 Date 10/16/07
Pump Tank: 1500 v Gallons; PT 46 Date 11/19/07
Pump Make: ZOELLER Model N-153A Serial No. 8161
Nitrification Field: No Fields 1 Square Feet 2000 Linear Feet 333
No Lines 6 Trench Width 24" min. Max Trench Bottom Depth 36" Gravel Depth NA ☐ Gravity ☑ Pressure

☐ New System ☐ Repair ☐ Expansion System Type: I II III (IV) V VI
System Description: LP PPBPS
Repair System Description: LP PP BPS
Maintenance Agreement Required: ☒ Yes ☐ No

☒ House/Mod. Home No. Bedrooms 5
☐ Mobile Home No. Persons 10
☐ Business No. Employees
☐ Other

Water Supply: ☒ Individual ☐ Public ☐ Community


☐ Slab ☒ Crawl Space ☒ Basement w/plumbing ☐ Basement wo/plumbing

Comments:/Conditions: Hold AC until existing well properly abandoned & certification submitted to health dept.
- Properly abandon existing septic system w/in 50' of new well

Comments:/Conditions: front 5/32" holes. Tanks, lines, valves, 1/16"

1" = 60'

INITIAL SITE SKETCH

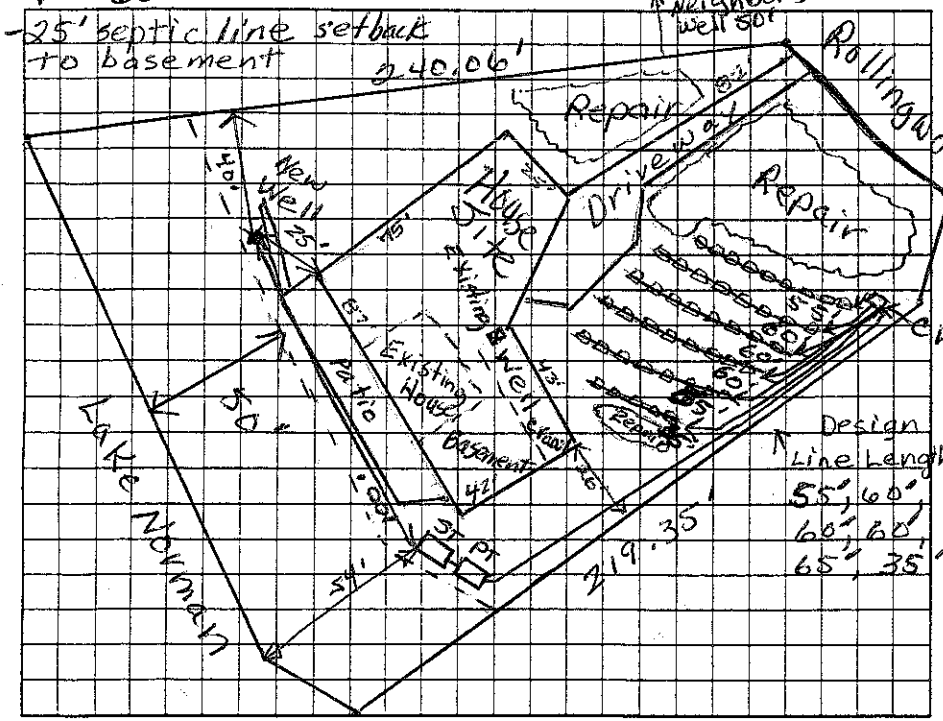

AS BUILT SKETCH

Permit can be suspended or revoked if any false information is supplied toward securing the permit/any unauthorized changes are made to the site/any unauthorized changes are made in the installation of the system. Improvement Permit with plat valid without expiration ☒ Improvement Permit with site plan valid for sixty months ☒ Authorization to Construct is valid for a period equal to that of Improvement Permit – not to exceed sixty months.

Signed: _____ date 5/18/07 Installed by: Rowan Septic Tank & Kirkpatrick Grading

Improvement Permit by: Judy Melville date 5-18-07 Operation Permit by: Wesley Sparks RS. date 5/19/08

Authorization to Construct by: Judy Melville date 6-22-07 Existing System Inspection by: _____ date _____

HEALTH DEPT. COPY: WHITE OWNER COPY (FINAL): YELLOW OWNER COPY (INITIAL): PINK