IREDELL COUNTY HEALTH DEPARTMENT

Statesville Office (704) 878-5305 Mooresville Office (704) 660-3625 PERMIT # 215223

IMPROVEMENT PERMIT / AUTHORIZATION TO CONSTRUCT / OPERATION PERMIT / EXISTING SYSTEM

PIN # 4625-08-3932.000

APPLICANT: LaFave's Construction APPLICANT ADDRESS: P.O. Drawer 8146 Landis NC 28088

SITE ADDRESS: 140 Old Arboretum Mooresville NC PHONE: 704-857-1171 ALT. PHONE: 704-467-0033

SITE DIRECTIONS: 85 S, TR Rollingwood, TL Barrar Ln., TL Old Arboretum

SUBDIVISION: Cliff SECTION: 7 LOT # 128 LOT AREA: 2.9 Acres DESIGN FLOW: Ex. 360 GPD T.A.R.: Existing

Septic Tank Existing (gal) STB Date
Pump Tank Existing (gal) PT Date
Pump Make NA Model Serial #
Nitrification Fields 1 # Lines NA 4 Linear Ft: NA
Trench Width NA Max. Trench Bottom Depth NA Gravel Depth 12"


☐ New System ☐ Repair ☐ Expansion System Type: I II III IV V VI
System Description: Existing 25% Red. - Pump
Repair System Description: Same (Exempt)
Maintenance Agreement Required: ☐ YES ☒ NO
☐ GRAVITY ☒ PRESSURE

☒ Residence No. Bedrooms Ex. 3
☐ Business No. Persons Ex 6
☐ Other No. Employees
☐ Slab ☒ Crawl Space
☐ Basement w/plumbing ☐ Basement w/o plumbing


Water Supply: ☒ Private ☐ Public ☐ Community

Comments / Conditions: Existing System Appeared To Be Functioning @ Time Of Inspection. Bathroom In Proposed Garage To Be Grinder Pumped To Existing Septic Tank

INITIAL SITE SKETCH

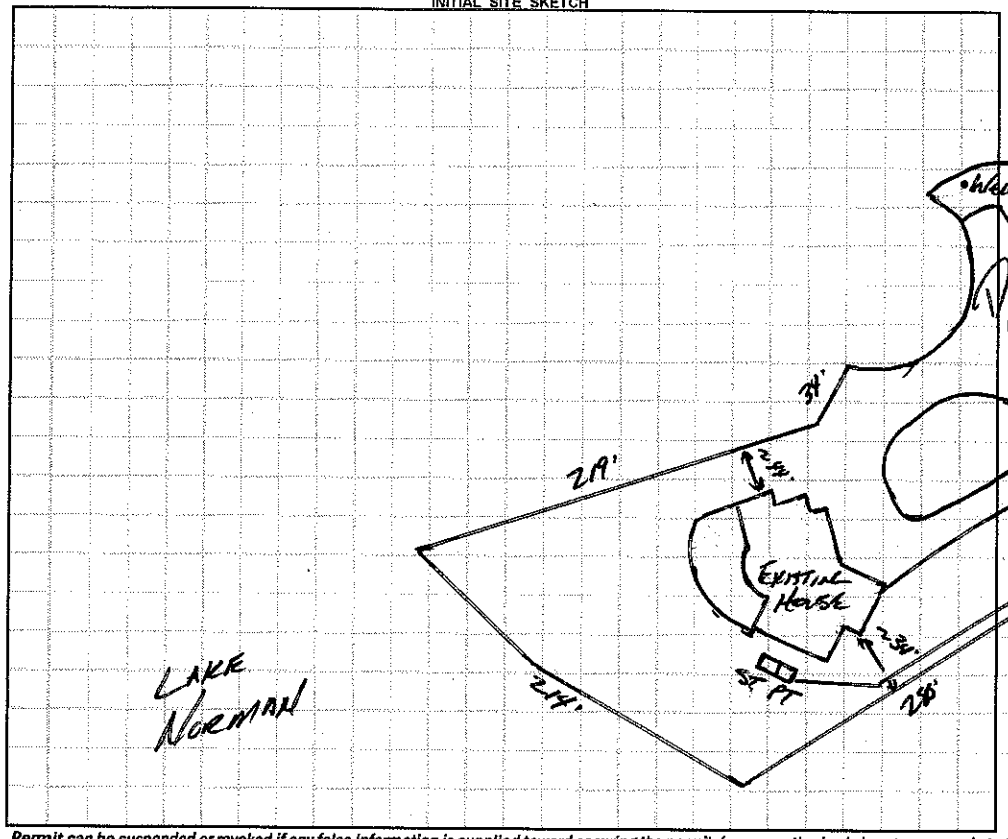

AS BUILT SKETCH

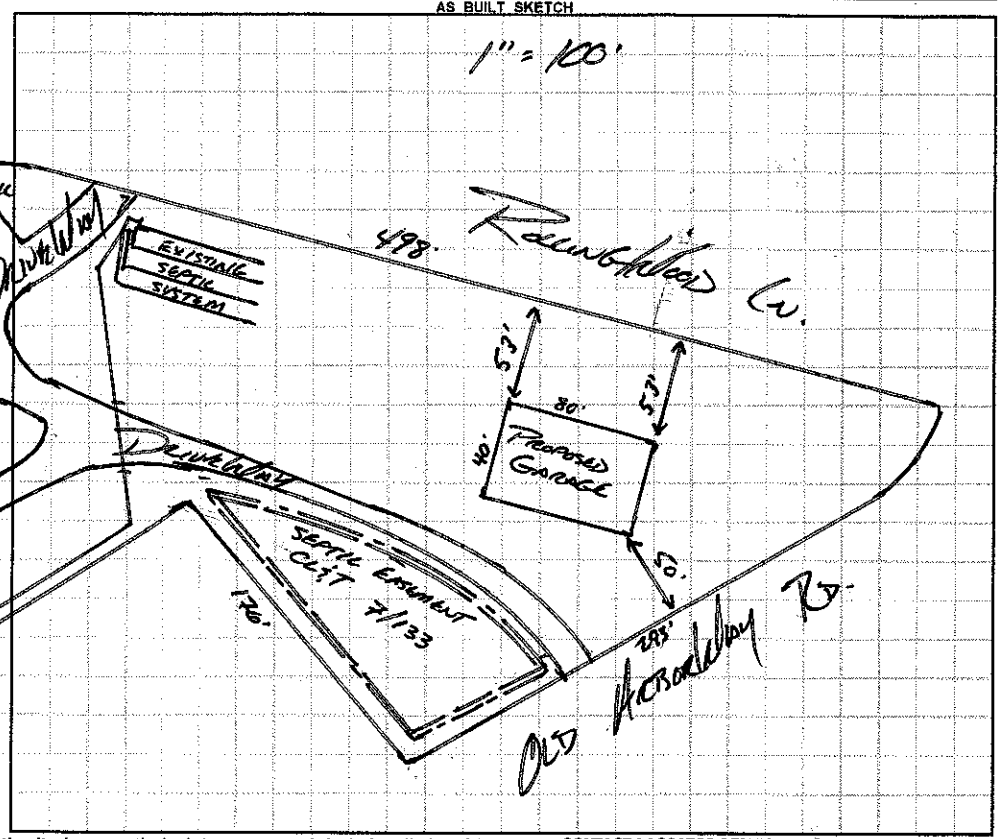

Permit can be suspended or revoked if any false information is supplied toward securing the permit / any unauthorized changes are made to the site / any unauthorized changes are made in the installation of the system. **CONTACT A LOCATOR SERVICE PRIOR TO ANY EXCAVATION**

☐ **IMPROVEMENT PERMIT** *with plat valid without expiration.* ☐ **IMPROVEMENT PERMIT** *with site plan valid for 60 mos.* ☐ **AUTHORIZATION TO CONSTRUCT** *valid for period equal to IMPROVEMENT PERMIT--not to exceed 60 mo.*

Owner / Applicant Signature: Cliff Hollar Date: 2/12/16 Installed by:

IMPROVEMENT PERMIT by: Date: OPERATION PERMIT by: Date:

AUTHORIZATION TO CONSTRUCT by: Date: Existing System Inspected by: Date: APPROVED FEB 03 2016

Health Dept. Copy - WHITE Applicant (Final Approval) - YELLOW Applicant (Conditional Approval) - PINK