IREDELL COUNTY HEALTH DEPARTMENT

STATESVILLE 704-878-5305 Ø MOORESVILLE 704-664-5281

IMPROVEMENT PERMIT / AUTHORIZATION TO CONSTRUCT / OPERATION PERMIT / EXISTING SYSTEM INSPECTION

PERMIT# 129378 PIN# 4625 08 7646 DATE 9/22/05

OWNER OR CONTRACTOR John R. Kindley PHONE: Business _____ Home _____

ADDRESS 157 Old Arboretum Rd, Mooresville NC 28117

LOCATION BSR TR Chuck Wood, TL Barber Lp; TL old Arboretum, on Lt

SUBDIVISION CLT BLOCK / SECTION 7 LOT 136 LOT AREA 0.715 SITE CLASS. PS DESIGN FLOW 360 L.T.A.R. —

Septic Tank: Existing Gallons: STB _____ Date _____

Pump Tank: _____ Gallons: PT _____ Date _____

Pump Make: _____ Model _____ Serial No. _____

Nitrification Field: No Fields ____ Square Feet _____ Linear Feet _____

No Lines _____ Trench Width _____ Max Trench Bottom Depth _____ Gravel Depth _____

☐ New System ☐ Repair System Type: I, (II), III, IV, V, VI

System Description: Ex. Conventional Bed

Repair System Description: _____

Maintenance Agreement Required: ☐ Yes ☒ No

☒ House/Mod. Home No. Bedrooms 3

☐ Mobile Home No. Bathrooms ____

☐ Business No. Employees ____

☐ Other _____

☐ Slab ☒ Crawl Space ☐ Basement w/plumbing ☐ Basement wo/plumbing

Water Supply: ☒ Individual ☐ Public ☐ Community


Comments:/Conditions:

1"=50'

Comments:/Conditions:

Existing Permit - Leonard Piedmont 1979 Attached

INITIAL SITE SKETCH

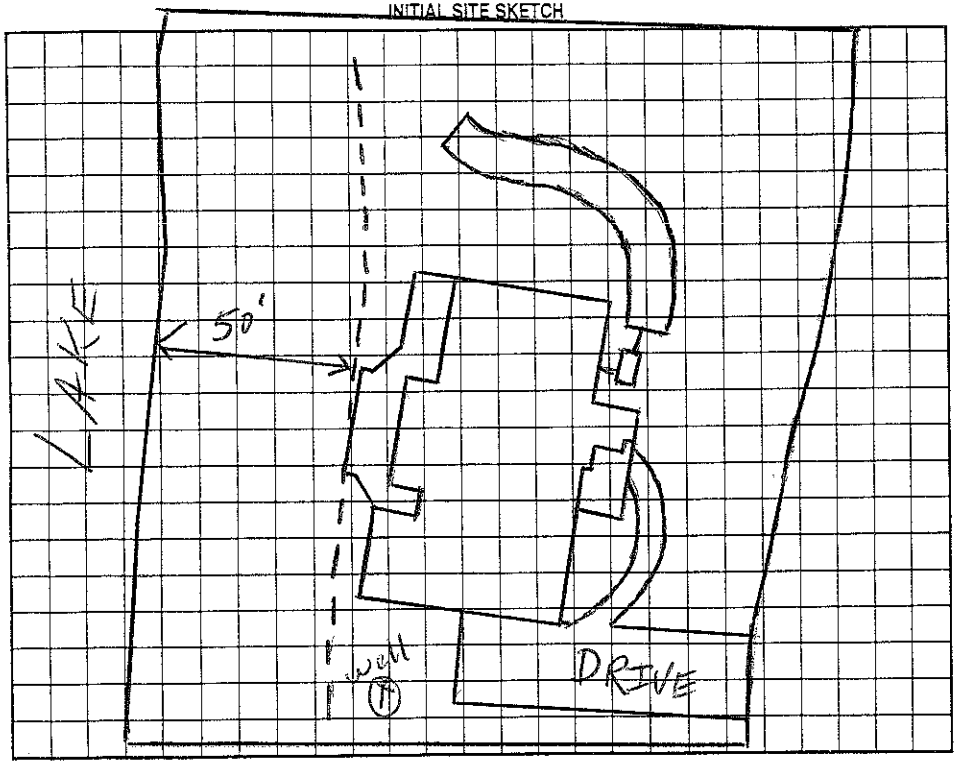

AS BUILT SKETCH

Permit can be suspended or revoked if any false information is supplied toward securing the permit/any unauthorized changes are made to the site/any unauthorized changes are made in the installation of the system. Improvement Permit with plat valid without expiration. Improvement Permit with site plan valid for sixty months. Authorization to Construct is valid for a period equal to that of Improvement Permit – not to exceed sixty months.

Signed: _____ date 9/23/05 Installed by: _____

Improvement Permit by: _____ date 9/22/05 Operation Permit by: _____ date _____

Authorization to Construct by: _____ date _____ Existing System Inspection by: _____ date 9/22/05

HEALTH DEPT. COPY: WHITE OWNER COPY (FINAL): YELLOW OWNER COPY (INITIAL): PINK