IREDELL COUNTY HEALTH DEPARTMENT

Statesville Phone TR 3-7271 Mooresville Phone NO 3-1271

PERMIT TO INSTALL SEPTIC TANK

Permit No. 159 Permit Date 10-28- 1971

Owner Joe Cranfield Address Hamptonville

Installed By Olbison Address Mooresville

Location of Property 1100 to 1177 to 1459

Property on right off spur


Rd from 1459 Sec 2 Lot 122

Tank		Capacity		Length of Lines		Fixtures	
Block	( )	1000	(✓)	225'	( )	No. of Baths	(1)
Precast	(✓)	1250	( )	250'	( )	Dishwasher	( )
		1500	( )	Other 210		Garbage Grdr.	( )
		Other				Other	

NOTIFY HEALTH DEPARTMENT AT LEAST EIGHT HOURS BEFORE TANK IS TO BE INSPECTED.

Final Inspection 10-28- 1971 Approved (✓) Disapproved ( )

Remarks

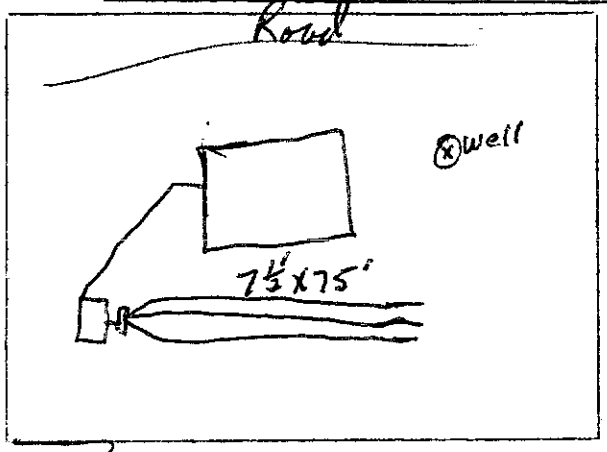

Sketch of Installation

J. C. Moore

Sanitarian