IREDELL COUNTY HEALTH DEPARTMENT

Statesville Phone TR 3-7271 Mooresville Phone NO 3-1271

PERMIT TO INSTALL SEPTIC TANK

Permit No. 58 Medcaf Permit Date 6-9 1971

Owner R R MEDCAEF Address KANNAPOLIS, NC

Installed By KANNAPOLIS SERV. Co. Address KANNAPOLIS, NC


Location of Property Lot 120 - Section 7
Road # 1177 - OFF BRAWLEY SCHOOL Rd

Tank		Capacity		Length of Lines		Fixtures	
Block	( )	1000	(✓)	225'	(✓)	No. of Baths	(1)
Precast	(✓)	1250	( )	250'	( )	Dishwasher	( )
		1500	( )	Other		Garbage Grdr.	( )
		Other				Other	

NOTIFY HEALTH DEPARTMENT AT LEAST EIGHT HOURS BEFORE TANK IS TO BE INSPECTED.

Final Inspection 6-9 1971 Approved (✓) Disapproved ( )

Remarks

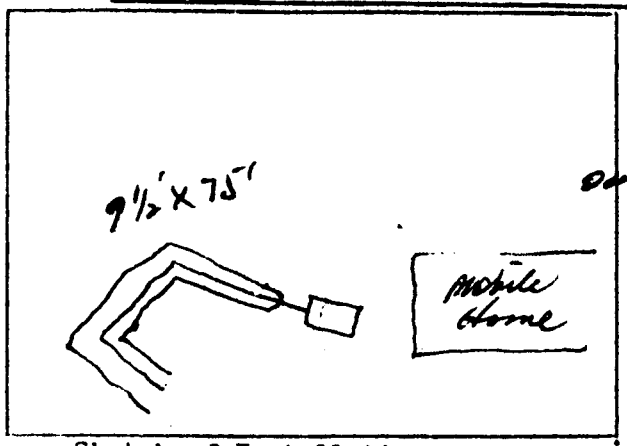

Sketch of Installation

Glenn Fisher
Sanitarian