IREDELL COUNTY HEALTH DEPARTMENT

Statesville Office (704) 878-5305 Mooresville Office (704) 660-3625 PERMIT # 208470

IMPROVEMENT PERMIT / AUTHORIZATION TO CONSTRUCT / OPERATION PERMIT / EXISTING SYSTEM

PIN # 4625097428

APPLICANT: Michael Privott APPLICANT ADDRESS: 115 Old Arboway Rd Mooresville NC 28117

SITE ADDRESS: 115 Old Arboway Rd Mooresville PHONE: ALT. PHONE: 704 408 1871

SITE DIRECTIONS: Brawley School Rd TR Chvekwood TL 1st Barber Loop TL Old Arboway 2nd drive on left


SUBDIVISION: CL&T SECTION: 7 LOT # 142 LOT AREA: DESIGN FLOW: 360gpd L.T.A.R.:

Septic Tank	Exist	(gal)	STB		Date	☐ New System ☐ Repair ☐ Expansion	System Type: I II III IV V VI	☒ Residence	No. Bedrooms	3	Water Supply
Pump Tank		(gal)	PT		Date	System Description: Exist Gravity – Conventional		☐ Business	No. Persons	6	☐ Private
Pump Make		Model			Serial #	Repair System Description:		☐ Other	No. Employees		☐ Public
# Nitrification Fields	1	# Lines	3		Linear Ft: 240'	Maintenance Agreement Required:	☐ YES ☒ NO	☐ Slab	☒ Crawl Space		☐ Community
Trench Width	Exist.	Max. Trench Bottom Depth	Exist		Gravel Depth 12"	☒ GRAVITY	☐ PRESSURE	☐ Basement w/plumbing		☐ Basement w/o plumbing	

Comments / Conditions: Must keep Building / Workshop at least 5ft from Septic System.

The proposed Building (workshop) meets setbacks to well & Septic System. The proposed Building does not appear to impact existing Septic System

INITIAL SITE SKETCH

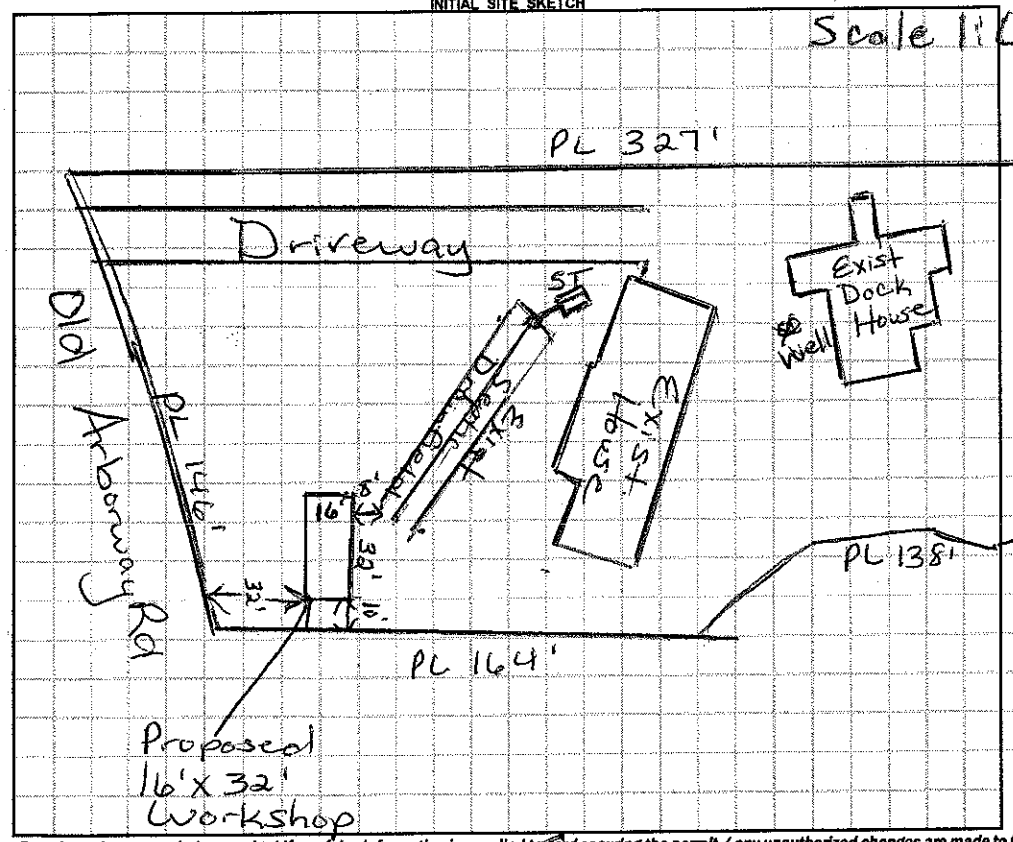

AS BUILT SKETCH

Permit can be suspended or revoked if any false information is supplied toward securing the permit / any unauthorized changes are made to the site / any unauthorized changes are made in the installation of the system. **CONTACT A LOCATOR SERVICE PRIOR TO ANY EXCAVATION**


☐ **IMPROVEMENT PERMIT** *with plat valid without expiration.* ☐ **IMPROVEMENT PERMIT** *with site plan valid for 60 mos.* ☐ **AUTHORIZATION TO CONSTRUCT** *valid for period equal to IMPROVEMENT PERMIT--not to exceed 60 mo.*

Owner / Applicant Signature: Date: 7/8/15 Installed by:

IMPROVEMENT PERMIT by: Date: OPERATION PERMIT by: Date:

AUTHORIZATION TO CONSTRUCT by: Date: Existing System Inspected by: Date: 5/21/15

Health Dept. Copy - WHITE Applicant (Final Approval) - YELLOW Applicant (Conditional Approval) - PINK

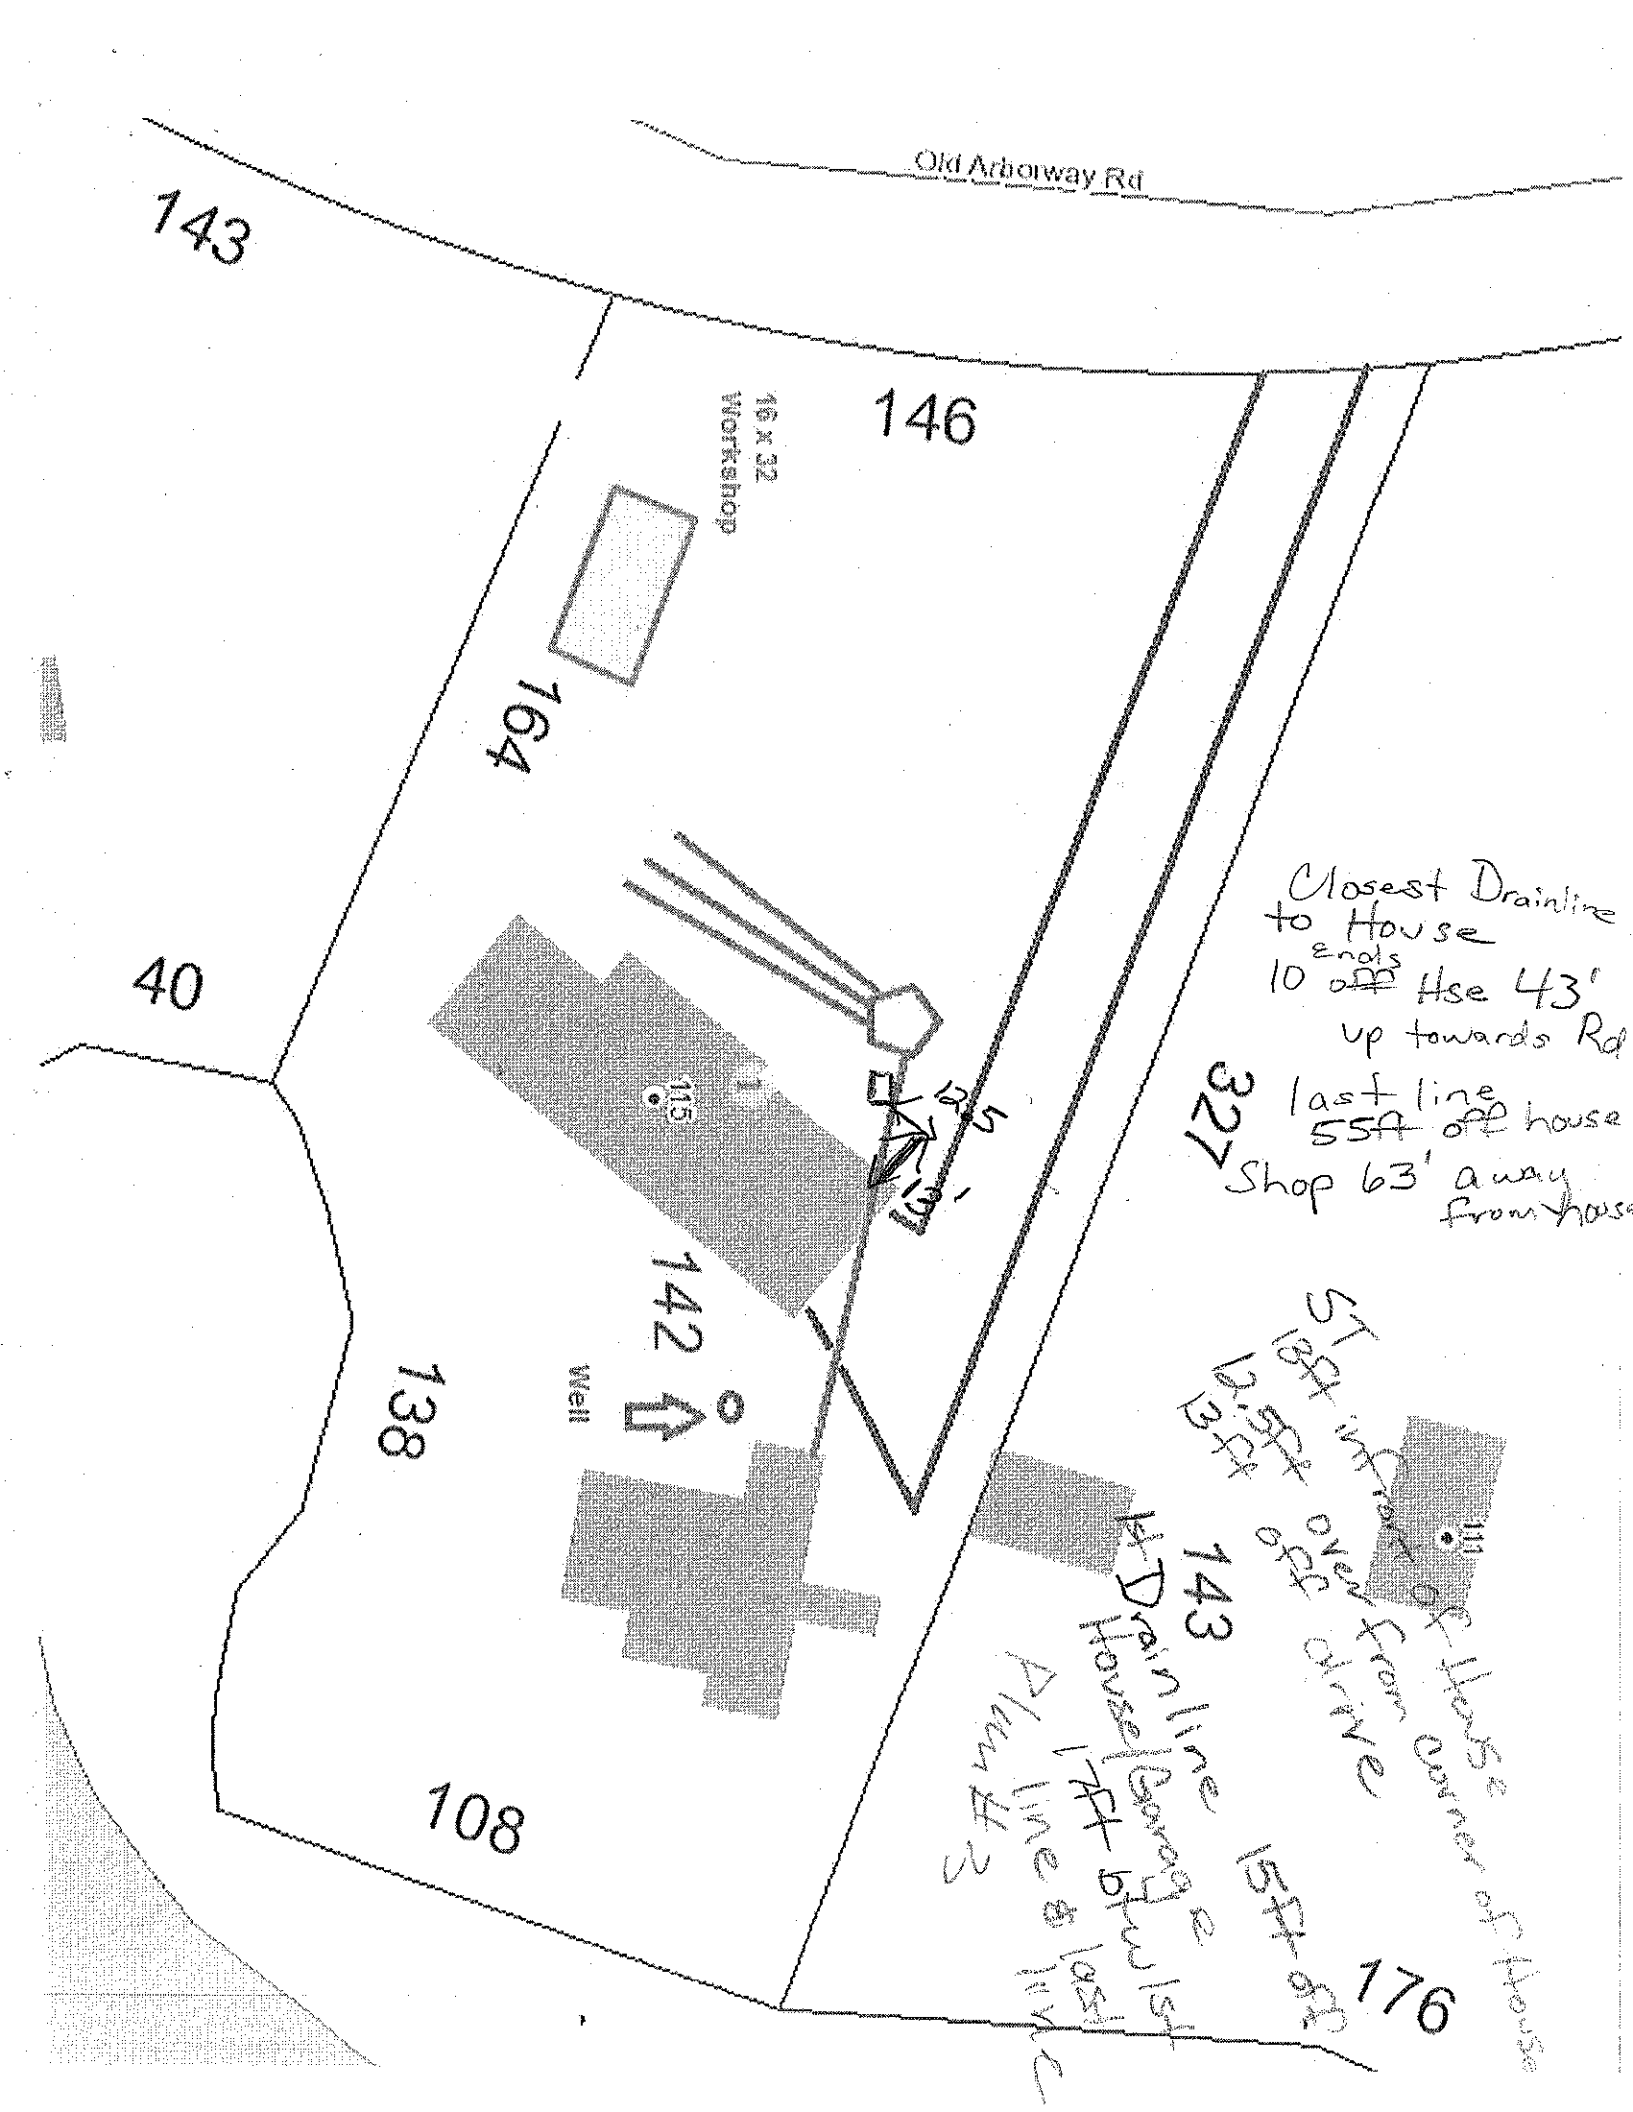
Old Arborway Rd
143
146
16 x 32 Workshop
164
40
115
142
Well
138
108
327
Closest Drainline to House
10 ends off Hse 43'
up towards Rd
last line 55ft off house
Shop 63' away from house
143
Drain line House Garage
176