1:00 — ★ Supply line revision — Pd #710 in Statesville

IREDELL COUNTY HEALTH DEPARTMENT

STATESVILLE 704-878-5305 — MOORESVILLE 704-664-5281

IMPROVEMENT PERMIT / AUTHORIZATION TO CONSTRUCT / OPERATION PERMIT / EXISTING SYSTEM INSPECTION

PERMIT # 175891 PIN # 4625097663 DATE 12-6-12

OWNER or APPLICANT Avalon Custom Building Group PHONE: Business 704-202-4390 Home: N/A

OWNER or APPLICANT ADDRESS 233 Wrenwood Dr. Charlotte

LOCATION / DIRECTIONS Brawley School Rd. TR Chestwood Rd TL Barber Lp TL Old Arboway Rd.

SUBDIVISION CLFT BLOCK / SECTION 57 LOT # 143 LOT AREA 1.13 acres DESIGN FLOW 360gpd L.T.A.R. 0.3

Septic Tank 1000 Gallons: STB 794 Date 4-7-13

Pump Tank 1000 Gallons: PT 283 Date 4-3-13

Pump Make Gould Model WE0312 Serial #

Nitrification Field No Fields 1 No Lines 4 Linear Feet 200

Trench Width 24" Max. Trench Bottom Depth 36" Gravel Depth N/A

☑ New System ☐ Repair ☐ Expansion System Type I II III IV V VI

System Description: LP PPBPS - ~~Pressure manifold~~

Repair System Description: Low Pressure PPBPS

Maintenance Agreement Required ☑ YES ☐ NO

☐ GRAVITY ☑ PRESSURE

☑ Residence No. Bedrooms 3 ☐ Business No. Persons ☐ Other No. Employees ☐ Slab ☑ Crawl Space ☐ Basement w/plumbing ☐ Basement w/o plumbing

Water Supply: ☑ Private ☐ Public ☐ Community


Comments / Conditions: Install a Panel block system on contour with Parallel distribution; 12 panels per line; Supply line shall be 30" deep at all points under driveway or encased in ductile iron.

Comments / Conditions: Pump & crush existing septic tank


Winkler Installed 5-10-13

6/11/13 Set 2# pressure 3/16" holes LOW PRESSURE INSTALLED.

INITIAL SITE SKETCH

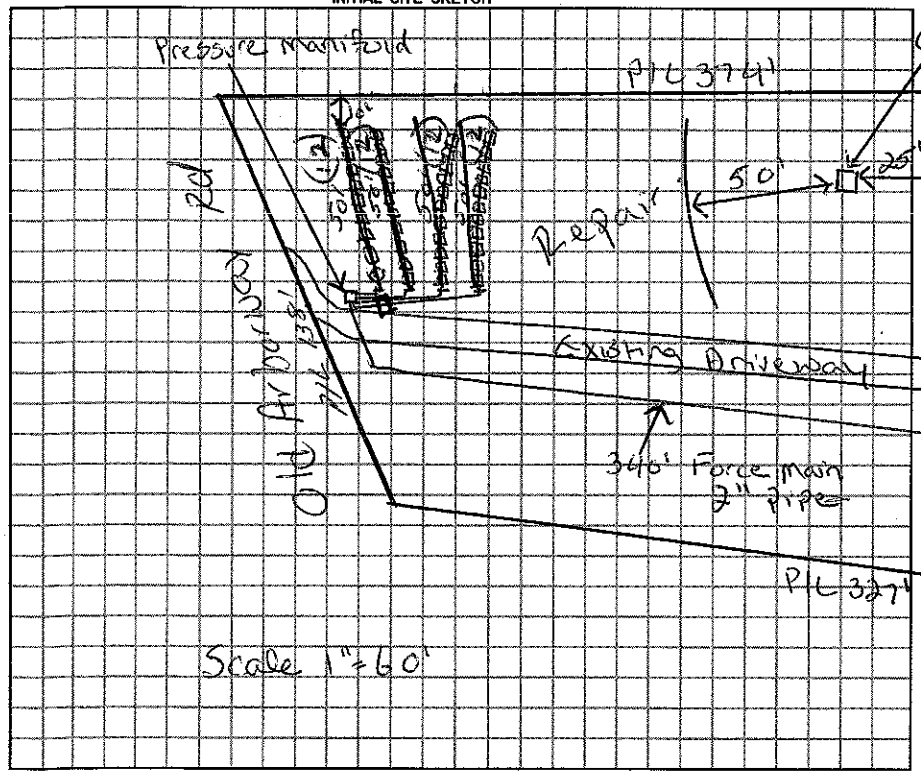

AS BUILT SKETCH

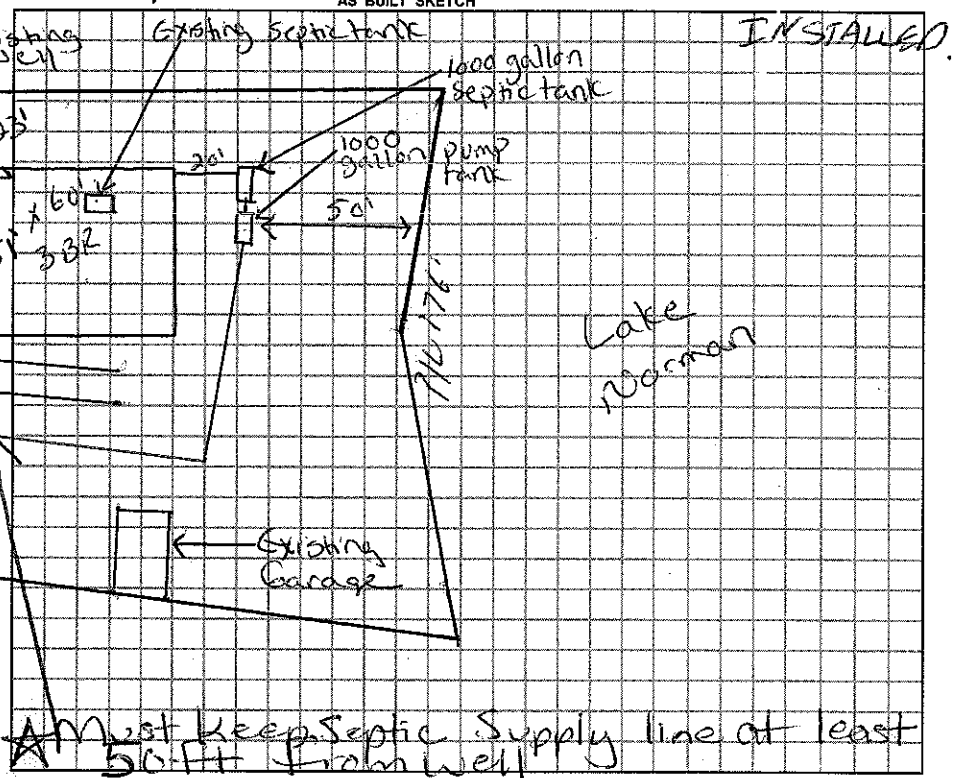

Permit can be suspended or revoked if any false information is supplied toward securing the permit / any unauthorized changes are made to the site / any unauthorized changes are made in the installation of the system.

☐ IMPROVEMENT PERMIT w / plan valid without expiration. ☐ IMPROVEMENT PERMIT w / site plan valid for 60 mos. ☑ AUTHORIZATION TO CONSTRUCT valid for period equal to IMPROVEMENT PERMIT-not to exceed 60 mo.

Owner / Applicant Signature: [signature] Date 12/12/12

Improvement Permit by: Justin Henderson Date 12-6-12

Authorization to Construct by: Justin Henderson Date 12-6-12

YOU SHOULD CONTACT A LOCATOR SERVICE PRIOR TO ANY EXCAVATION.

Installed by: RANDY

Operation Permit by: Maine H. Dobson RS Date: 6/11/13

Existing System Inspected by: Date:

WHITE COPY Environmental Health YELLOW COPY (Final) Owner / Applicant PINK COPY (Initial) Owner / Applicant