330-400

IREDELL COUNTY HEALTH DEPARTMENT

STATESVILLE 704-878-5305 MOORESVILLE 704-664-5281

IMPROVEMENT PERMIT / AUTHORIZATION TO CONSTRUCT / OPERATION PERMIT / EXISTING SYSTEM INSPECTION

PERMIT# 065652 PIN# 4625944684 4625-19-8595 DATE 3-13-2001

OWNER OR CONTRACTOR Crescent Resources / John Whitley PHONE: Business Home 6060-3978

ADDRESS 138 Cades Cove Ln, Mooresville NC 28117

LOCATION Brawley School Rd TR Bay Harbour TL Cedar Bluff 7th lot on Right

SUBDIVISION Harbour BLOCK / SECTION 6 LOT 34 LOT AREA 25,187 SITE CLASS. PS DESIGN FLOW 480gpd L.T.A.R. 0.3

Septic Tank: 1000 Gallons; STB 794 Date 10-16-01
Pump Tank: 1000 Gallons; PT 283 Date 10-29-01
Pump Make: Gowlds Model WE05111 Serial No. 11-14-01
Nitrification Field: No Fields 1 Square Feet 560'+ Linear Feet 280'
No Lines 4 at 70' Trench Width 24"-36" Max Trench Bottom Depth 30" Gravel Depth N/A

☒ New System ☐ Repair System Type: I, II, III, IV, V, VI
System Description: Pump-Up-Paver Block
Repair System Description: Same
Maintenance Agreement Required: ☒ Yes ☐ No


☒ House/Mod. Home No. Bedrooms 4
☐ Mobile Home No. Bathrooms 4
☐ Business No. Employees
☐ Other
☐ Slab ☐ Crawl Space ☒ Basement w/plumbing ☐ Basement wo/plumbing

Water Supply:
☐ Individual
☒ Public
☒ Community

Comments/Conditions: Keep Septic System at least 10' from PL & 50' From Lake. 25' Setback between Basement wall & Drainfield.

Comments/Conditions: Maintenance from Tri County

INITIAL SITE SKETCH Scale 1:50

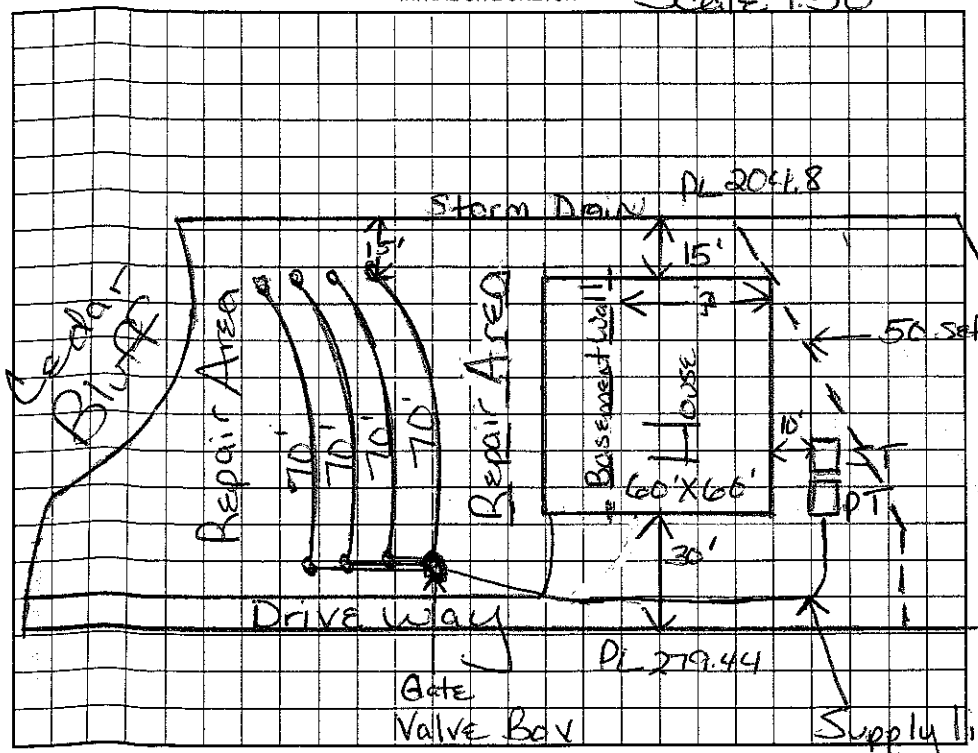

AS BUILT SKETCH

Permit can be suspended or revoked if any false information is supplied toward securing the permit/any unauthorized changes are made to the site/any unauthorized changes are made in the installation of the system. Improvement Permit with plat valid without expiration. Improvement Permit with site plan valid for sixty months. Authorization to Construct is valid for a period equal to that of Improvement Permit – not to exceed sixty months.

Signed: Jennifer C Whitley date 3/13/2001 Installed by: Curt Dunning

Improvement Permit by: Myra H H Dotson RS date 3/13/2001 /Operation Permit by: Wesley Sparks RS date 12/28/01

Authorization to Construct by: Myra H H Dotson RS date 3/13/2001 Existing System Inspection by: date

HEALTH DEPT. COPY: WHITE OWNER COPY (FINAL): YELLOW OWNER COPY (INITIAL): PINK