IREDELL COUNTY HEALTH DEPARTMENT

(TR-Swp yard PK)

STATESVILLE 704-878-5305 MOORESVILLE 704-664-5281

230

IMPROVEMENT PERMIT / AUTHORIZATION TO CONSTRUCT / OPERATION PERMIT / EXISTING SYSTEM INSPECTION

PERMIT# 065651 PIN# 4625941684PT 4625 19 9644 DATE 5/2/2000

OWNER OR CONTRACTOR Crescent Resources/Greg Fisher PHONE: Business Greg Home 646 2-6607

ADDRESS 400 S. Tryon St Charlotte, NC 28201

LOCATION Brawley School Rd TR Bay Harbour TL Cedar Bluff - 6th lot on right 128 Cedar Bluff

SUBDIVISION Harbour BLOCK / SECTION VI LOT 33 LOT AREA 27850 SITE CLASS. PS DESIGN FLOW 480 gpd L.T.A.R. .3

Septic Tank: 1000 Gallons; STB 794 Date 11-6-2000

Pump Tank: 1000 Gallons; PT 37 Date 1-5-2001

Pump Make: Goulds Model WE05111H Serial No: 5020600691

Nitrification Field: No Fields 1 Square Feet 1206' Linear Feet 402'

No Lines 6 at 67 Trench Width 36" Max Trench Bottom Depth 36" Gravel Depth N/A

☒ New System ☐ Repair System Type: I, II, III, IV, V, VI

System Description: Pump (Pm) to 25% Reduction

Repair System Description: Pump to Innovative

Maintenance Agreement Required: ☐ Yes ☒ No

☒ House/Mod. Home ☐ Mobile Home ☐ Business ☐ Other

No. Bedrooms 4 No. Bathrooms 3.5 No. Employees


☐ Slab ☒ Crawl Space ☐ Basement w/plumbing ☐ Basement wo/plumbing

Water Supply: ☐ Individual ☐ Public ☒ Community


Comments:/Conditions: Keep Septic System 10' from PL & 50' From lake

Comments:/Conditions: Tanks, lines & pressure checked 2/20/2001 MD

INITIAL SITE SKETCH Scale 1:50

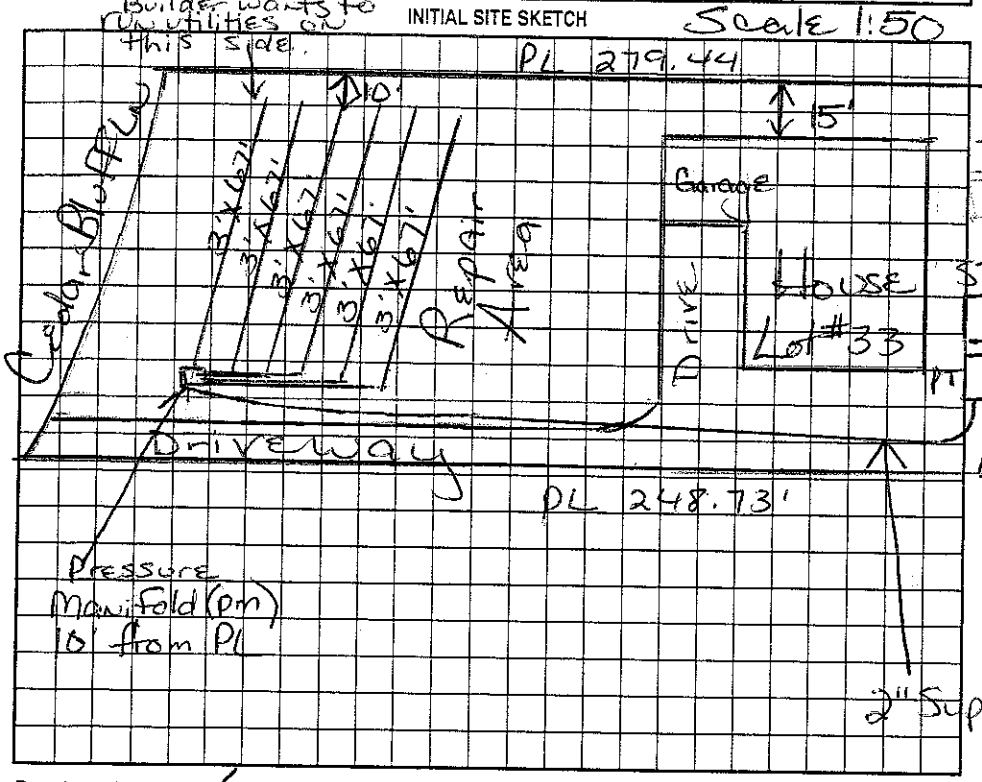

AS BUILT SKETCH

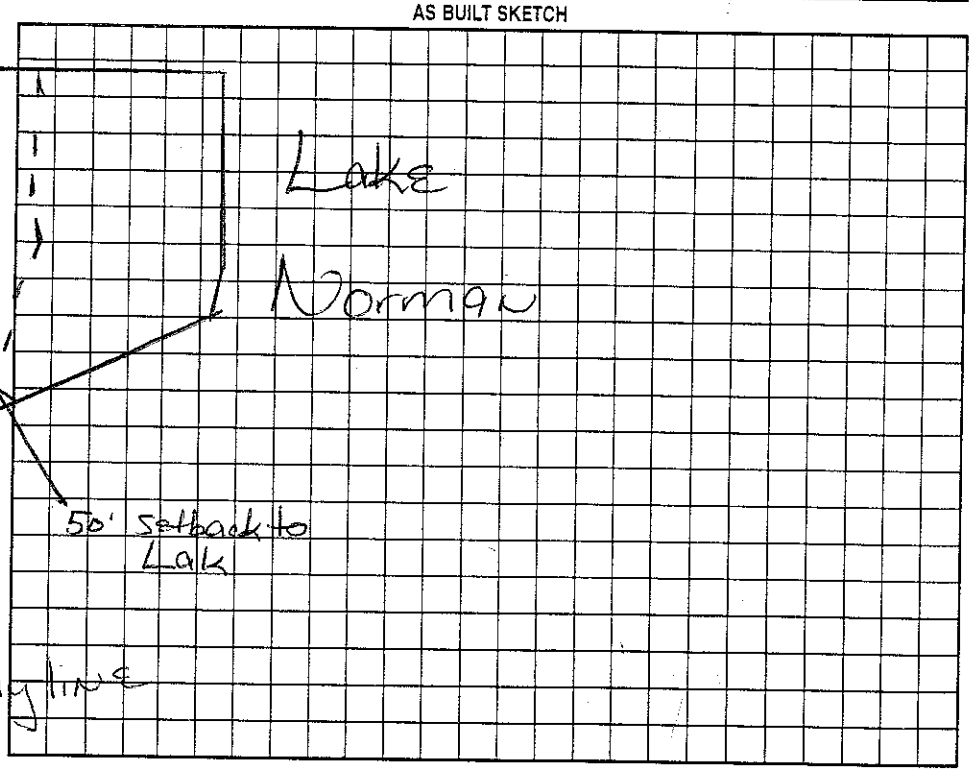

Permit can be suspended or revoked if any false information is supplied toward securing the permit/any unauthorized changes are made to the site/any unauthorized changes are made in the installation of the system. Improvement Permit with plat valid without expiration. Improvement Permit with site plan valid for sixty months. Authorization to Construct is valid for a period equal to that of Improvement Permit – not to exceed sixty months.

Signed: [signature] date

Improvement Permit by: Maria H. Dotson RS date 5/2/2000

Authorization to Construct by: Maria H. Dotson RS date 5/2/2000

Installed by: Wayne Orbison

Operation Permit by: [signature] RS date 11/14/02

Existing System Inspection by: date

HEALTH DEPT. COPY: WHITE OWNER COPY (FINAL): YELLOW OWNER COPY (INITIAL): PINK