Permit #106795

4625-26-3896

11:00

IREDELL COUNTY HEALTH DEPARTMENT Const. Auth. STATESVILLE 704-878-5305 MOORESVILLE 704-664-5281

IMPROVEMENT PERMIT / ~~CERTIFICATE OF COMPLETION~~ / OPERATION PERMIT / EXISTING SYSTEM INSPECTION

PROPERTY DESCRIPTION NO. 24774 / 044911 DATE Sept 6, '96 TAX MAP NO. part of 2CA3 Watershed: ☑ Yes ☐ No

OWNER OR CONTRACTOR Crescent Resources LLC / KELLY BUILDERS PHONE: Business _____ Home _____

ADDRESS PO Box 1033, Charlotte #498 Bay Harbor

LOCATION Brawley Sch Rd. TR Bay Harbour Rd. At end

SUBDIVISION The Harbour BLOCK / SECTION 5 LOT 24 LOT AREA ≈ 20,000 ft² SITE CLASS. PSpr. 1756 DESIGN FLOW 440gpd L.T.A.R. ~.3

Septic Tank: 1000 Gallons; STB 794 Date 3/12/03

Pump Tank: 1000 Gallons; PT 27 Date 3/2/03

Pump Make: Meyers Model D102 Serial No. _____

Nitrification Field: No Fields 1 Square Feet 1200 Linear Feet 400

No Lines 4@100' Trench Width 36" Max Trench Bottom Depth ~30" Gravel Depth NA

☑ New System ☐ Repair System Type: I, II, III, IV, V, VI

System Description: pumped pm - chambered

Repair System Description: LP Panel Blake

Maintenance Agreement Required: ☐ Yes ☑ No

☑ House/Mod. Home ☐ Mobile Home ☐ Business ☐ Other

No. Bedrooms 4/4 No. Bathrooms _____ No. Employees _____


☐ Slab ☑ Crawl Space ☐ Basement w/plumbing ☐ Basement wo/plumbing

Water Supply: ☐ Individual ☐ Community ☑ Public


Comments: 1) House IS ~~SLIGHTLY~~ SLIGHTLY LARGER THAN DRAWN, BUT SYSTEM IS OFFSITE.
2) 4 BR House

Comments: Installed 500 Gal Easy Flow
Drainfield Checked 4/17/03
Tanks Checked 5/12/03

INITIAL SITE SKETCH

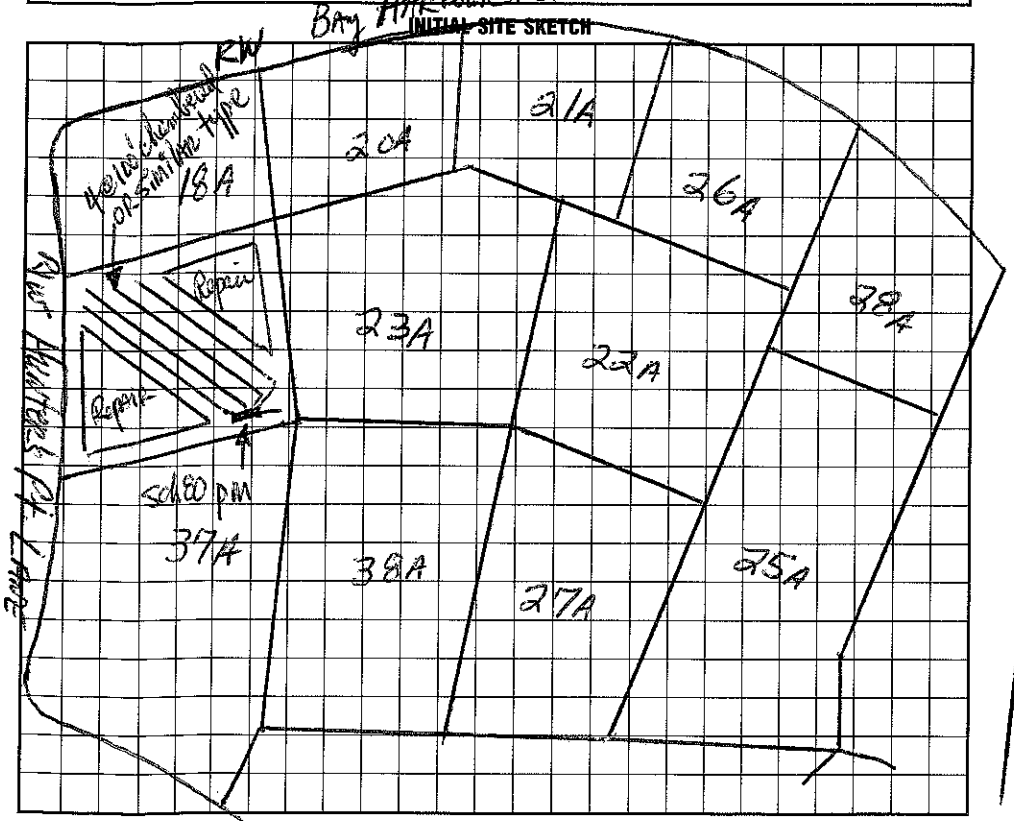

AS BUILT SKETCH

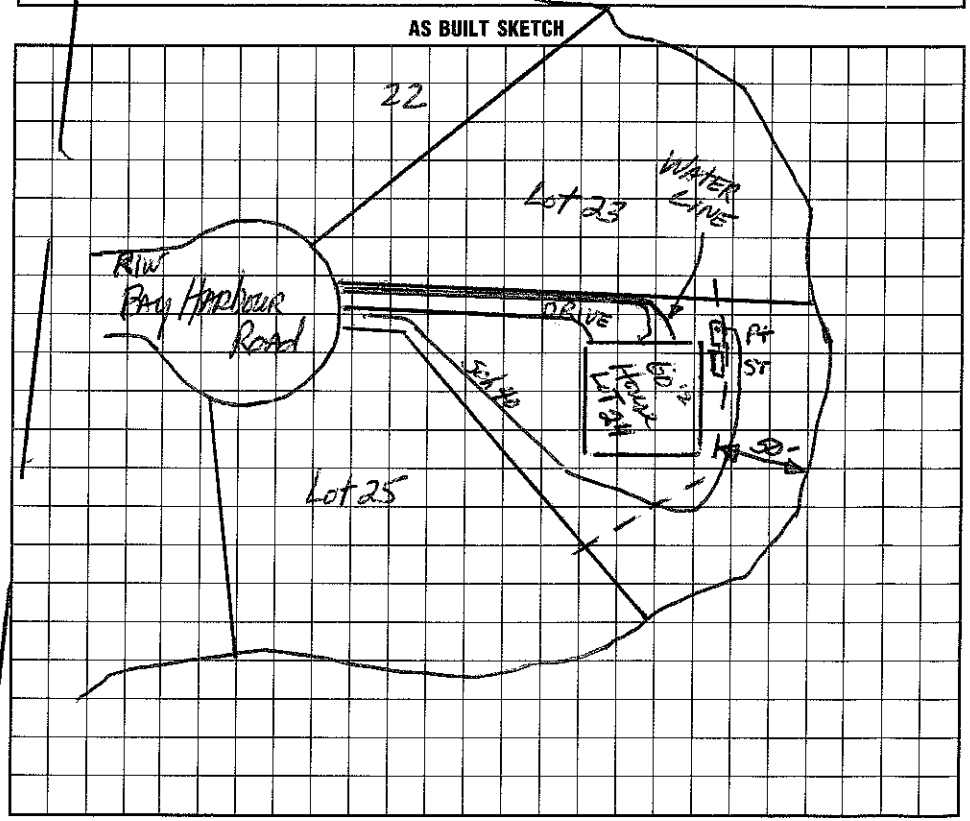

I understand that this permit can be suspended or revoked if any false information is supplied toward securing the permit/any unauthorized changes are made to the site/any unauthorized changes are made in the installation of the system.

Installed by: R & H Inc RS

Improvement Permit by: _____ RS date 9-6-96

Certificate of Completion by: _____ date 6/4/03

System Inspection by: _____ RS date 1/24/02

Operation Permit by: _____ RS date 6/4/03

HEALTH DEPT. COPY: WHITE INSPECTION COPY (FINAL): GREEN OWNER COPY (FINAL): YELLOW INSPECTION COPY (INITIAL): PINK OWNER COPY (INITIAL): GOLD