IREDELL COUNTY HEALTH DEPARTMENT Const. Auth. STATESVILLE 704-878-5305 MOORESVILLE 704-664-5281

IMPROVEMENT PERMIT / ~~CERTIFICATE OF COMPLETION~~ / OPERATION PERMIT / EXISTING SYSTEM INSPECTION

PROPERTY DESCRIPTION NO. 24373 DATE Sept 6 '96 TAX MAP NO. part of 2CA3 4625264759 Watershed: ☑ Yes ☐ No

OWNER OR CONTRACTOR Crescent Resources Inc William Boyce PHONE: Business _____ Home _____

ADDRESS PO Box 1003 Charlotte

LOCATION Bayley Spk Rd TR Bay Harbour Rd. at end

SUBDIVISION The Harbour BLOCK / SECTION 5 LOT 23 LOT AREA >20,000 ft² SITE CLASS. PSpec 1996 DESIGN FLOW 460gpd L.T.A.R. ~.3

Septic Tank: 1000 Gallons; STB 794 Date 7/6/98

Pump Tank: 1000 Gallons; PT _____ Date 7/14/98

Pump Make: MYERS Model ME-100S21 Serial No. 120197

Nitrification Field: No Fields 1 Square Feet 1200 Linear Feet 400

No Lines ~~4@100'~~ 5@80' Trench Width 36" Max Trench Bottom Depth ~30" Gravel Depth N/A

☑ New System ☐ Repair System Type: I, II, III, IV, V, VI

System Description: pumped pp - chambered 23A

Repair System Description: LPP Panel Block 23A

Maintenance Agreement Required: ☐ Yes ☑ No

☑ House/Mod. Home No. Bedrooms 4

☐ Mobile Home No. Bathrooms 4

☐ Business No. Employees _____

☐ Other _____


☐ Slab ☑ Crawl Space ☐ Basement w/plumbing ☐ Basement wo/plumbing

Water Supply: ☐ Individual ☐ Community ☑ Public


Comments:

Comments: 5 lines 80' x 3' installed

INITIAL SITE SKETCH

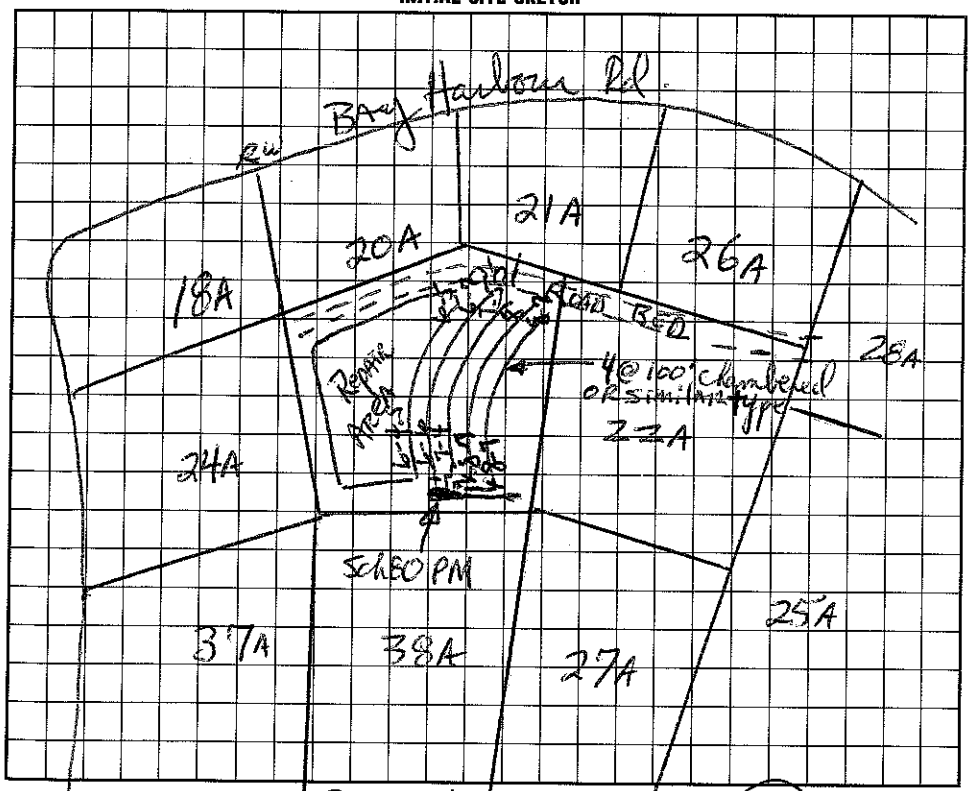

AS BUILT SKETCH

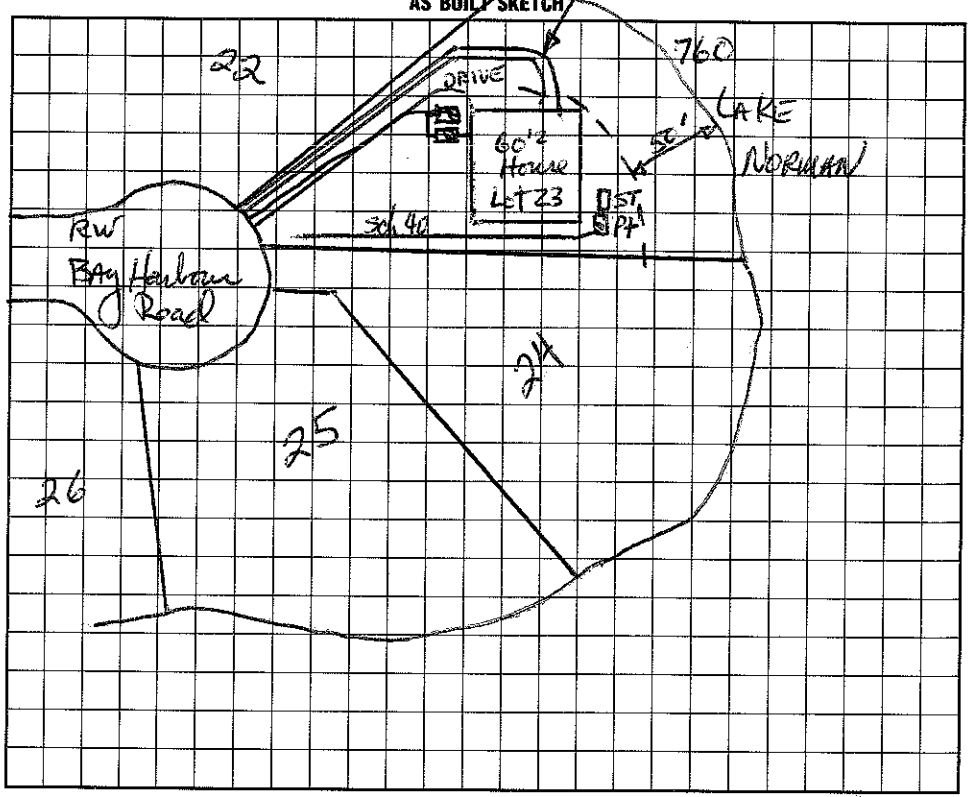

I understand that this ~~permit~~ can be suspended or revoked if any false information is supplied toward securing the permit/any unauthorized changes are made to the site/any unauthorized changes are made in the installation of the system.

Signed: Terry Clary / CPSS (Agent)

Improvement Permit by: Terry Clary RS date 9-6-96

~~Construction~~ Existing System Inspection by: R Hinson RS date 12-18-97

~~Authorization~~ HEALTH DEPT. COPY: WHITE INSPECTION COPY (FINAL): GREEN OWNER COPY (FINAL): YELLOW

Installed by: Chris Hedrick - Brad Russell

Certificate of Completion by: _____ date _____

Operation Permit by: Wesley Sparks RS. date 1/28/99

INSPECTION COPY (INITIAL): PINK OWNER COPY (INITIAL): GOLD