IREDELL COUNTY HEALTH DEPARTMENT Const. Auth. STATESVILLE 704-878-5305 MOORESVILLE 704-6(1

IMPROVEMENT PERMIT / ~~CERTIFICATE OF COMPLETION~~ / OPERATION PERMIT / EXISTING SYSTEM SPECTION

PROPERTY DESCRIPTION NO. 24375 DATE Sept. 9'96 TAX MAP NO. ~~part of 2043~~ 4625-26-4959 Watershed: ☑ Yes ☐ No

OWNER OR CONTRACTOR Crescent Resources Inc. / Augusta Homes PHONE: Business _____ Home _____

ADDRESS PO Box 1003 Charlotte

LOCATION Brawley Sch Rd. TR Bay Harbour Rd. AT END

SUBDIVISION The Harbour BLOCK / SECTION 5 LOT 25 LOT AREA ≥ 24,000 ft² SITE CLASS. B pre 1958 DESIGN FLOW 460 gpd L.T.A.R. ~.3

Septic Tank: 1000 Gallons; STB 794 Date 7/28/01
Pump Tank: 1000 Gallons; PT 338 Date 8/20/01
Pump Make: Myers Model ME 75 2 Serial No. 2532500116
Nitrification Field: No Fields 1 Square Feet 540 Linear Feet 270
No Lines 3@90' Trench Width 24" Max Trench Bottom Depth ≈ 30" Gravel Depth NA

☑ New System ☐ Repair System Type: I, II, III, (IV) V, VI
System Description: LP Panel Block on 25A
Repair System Description: LP Panel Block on 25A
Maintenance Agreement Required: ☑ Yes ☐ No

☑ House/Mod. Home No. Bedrooms 4
☐ Mobile Home No. Bathrooms 4
☐ Business No. Employees ____
☐ Other ____

☐ Slab ☑ Crawl Space ☐ Basement w/plumbing ☐ Basement wo/plumbing

Water Supply:
☐ Individual
☐ Community
☑ Public


Comments:

Comments: Filter & riser installed
Checked tanks & drainlines 10/16/2001
Press, eject & alarm 1/17/2002

INITIAL SITE SKETCH



AS BUILT SKETCH

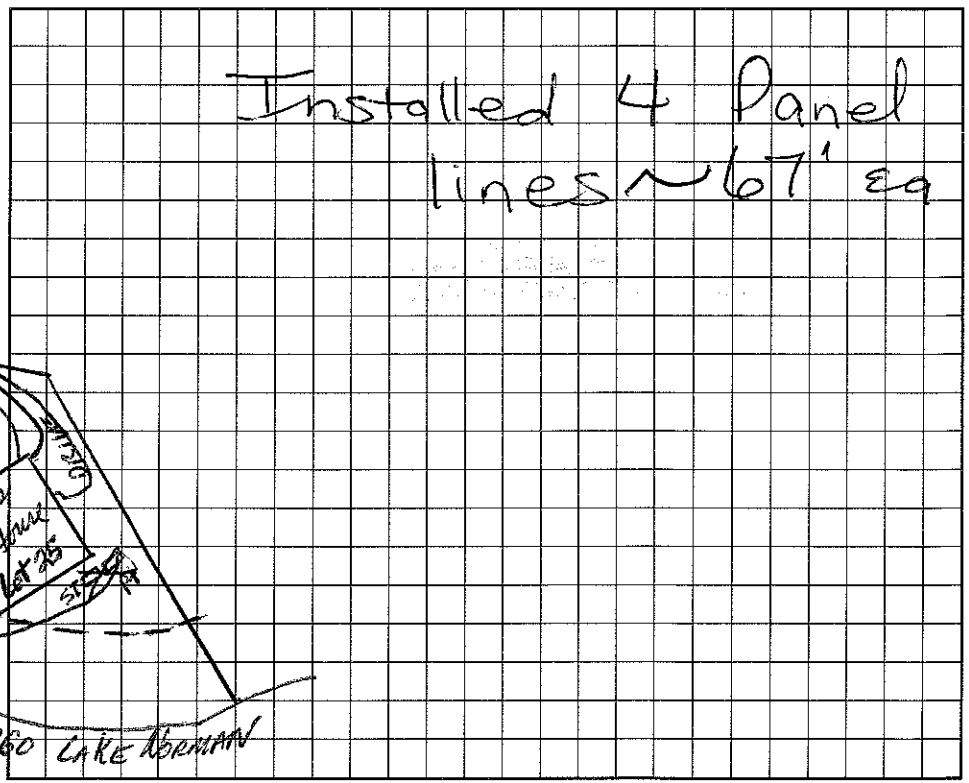

I understand that this permit can be suspended or revoked if any false information is supplied toward securing the permit/any unauthorized changes are made to the site/any unauthorized changes are made in the installation of the system.

Signed: _____

Improvement Permit by: _____ date 9-9-96

~~Existing System Inspection by:~~ Construction Authorization _____ date 2-7-01

Installed by: R & H Inc

Certificate of Completion by: _____ date 1/17/2002

Operation Permit by: _____ date _____

HEALTH DEPT. COPY: WHITE INSPECTION COPY (FINAL): GREEN OWNER COPY (FINAL): YELLOW INSPECTION COPY (INITIAL): PINK OWNER COPY (INITIAL): GOLD