IREDELL COUNTY HEALTH DEPARTMENT

STATESVILLE 704-878-5305 MOORESVILLE 704-664-5281

10:00

IMPROVEMENT PERMIT / AUTHORIZATION TO CONSTRUCT / OPERATION PERMIT / EXISTING SYSTEM INSPECTION

PERMIT# 116634 PIN# 4625 26 7911 DATE 10/20/03

OWNER OR CONTRACTOR Kelly Building + Development Corp. PHONE: Business 704-664-9222 Home

ADDRESS PO Box 3081 Mooresville, NC. 28115

LOCATION 1100, TR Bay Harbor to end, on (L) just B4 Cul de Sac

SUBDIVISION Harbor BLOCK / SECTION 5 LOT 21 LOT AREA .58 SITE CLASS PS DESIGN FLOW 480 L.T.A.R. .3

Septic Tank: 1000 Gallons; STB 312 Date 9/13/03
Pump Tank: 1000 Gallons; PT 283 Date 9-14-03
Pump Make: Myers Model ME50 Serial No.
Nitrification Field: No Fields 1 Square Feet 532/798 Linear Feet 266
No Lines 3 @ 88' Trench Width 2-3' Max Trench Bottom Depth 30" Gravel Depth N/A

[X] New System [ ] Repair System Type: I, II, III, (IV), V, VI
System Description: Pres Dosed - 16" PP BPS
Repair System Description: Some of SFE 21A
Maintenance Agreement Required: [X] Yes [ ] No
[ ] Slab [ ] Crawl Space [X] Basement w/plumbing [ ] Basement wo/plumbing

[X] House/Mod. Home No. Bedrooms 4
[ ] Mobile Home No. Bathrooms 4.5
[ ] Business No. Employees
[ ] Other


Water Supply: [ ] Individual [ ] Public [X] Community

Comments/Conditions: 2' ON 8' CNTRS / 3' ON 9' CNTRS
HOUSE SIZE CHANGED & # OF BDRMS.
DO NOT GRADE, FILL, OR COMPACT DRAINFIELD


Comments/Conditions: Checked tanks 10/30/03
Lines checked by WS 6/25/04
Pressure, elect & alarm 8/17/04 MD

(1" = 40')

INITIAL SITE SKETCH

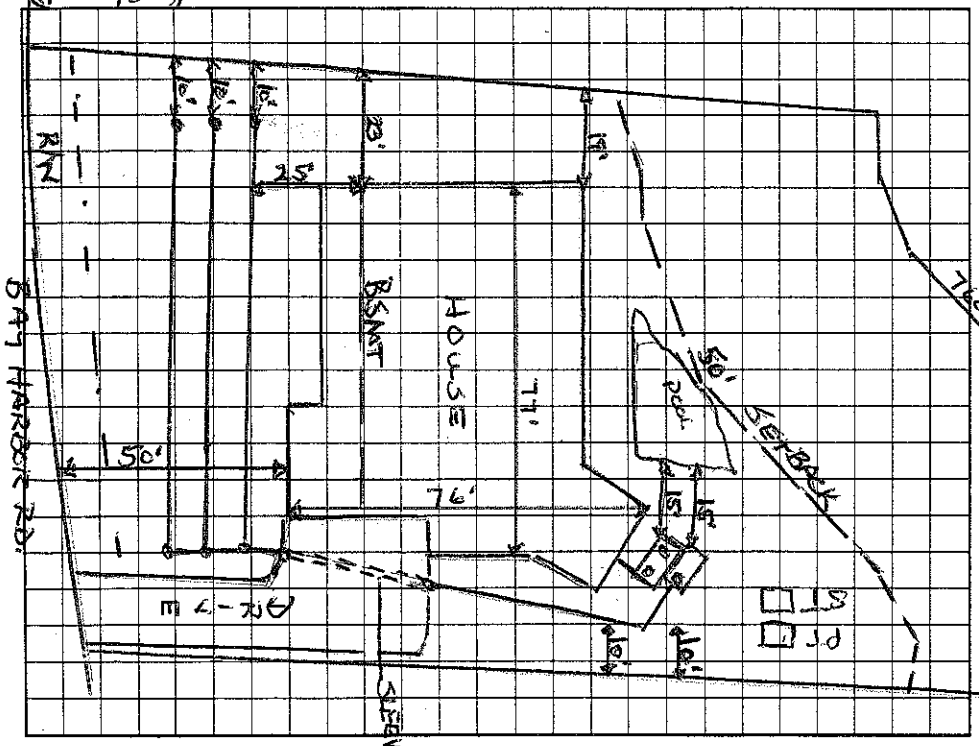

AS BUILT SKETCH

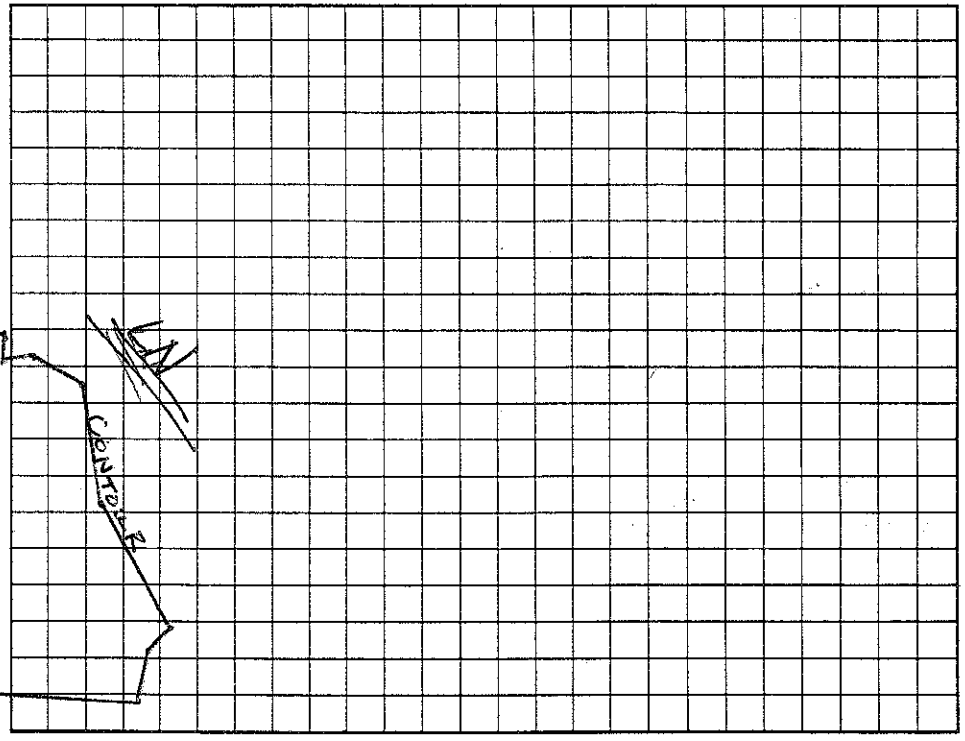

Permit can be suspended or revoked if any false information is supplied toward securing the permit/any unauthorized changes are made to the site/any unauthorized changes are made in the installation of the system. Improvement Permit with plat valid without expiration. Improvement Permit with site plan valid for sixty months. Authorization to Construct is valid for a period equal to that of Improvement Permit – not to exceed sixty months.

Signed: * Matthew B Kelly date 10/21/03 Installed by: R & T RS

Improvement Permit by: Wesley Sparks RS. date 10/20/03 Operation Permit by: Maria H Dotson date 8/17/04

Authorization to Construct by: Wesley Sparks RS. date 10/20/03 Existing System Inspection by: date

HEALTH DEPT. COPY: WHITE OWNER COPY (FINAL): YELLOW OWNER COPY (INITIAL): PINK