IREDELL COUNTY HEALTH DEPARTMENT

STATESVILLE 704-878-5305 — D — MOORESVILLE 704-664-5281

IMPROVEMENT PERMIT / AUTHORIZATION TO CONSTRUCT / OPERATION PERMIT / EXISTING SYSTEM INSPECTION

PERMIT# 120871 PIN# 4625 27 2899 DATE 5/10/04

OWNER OR CONTRACTOR Tom Stevenson Co. PHONE: Business 704-662-0105 Home

ADDRESS 816-G Brawley School Rd. Mooresville NC. 28115

LOCATION 1100, TR Bay Harbour TR Hunters Pt. TL Pointe

SUBDIVISION Harbour BLOCK / SECTION 5 LOT 38-38A LOT AREA ~.87 SITE CLASS. DESIGN FLOW 480 L.T.A.R.

Septic Tank: Gallons; STB Date

Pump Tank: Gallons; PT Date

Pump Make: Model Serial No.

Nitrification Field: ☐ No Fields Square Feet EXISTING Linear Feet

☐ No Lines Trench Width Max Trench Bottom Depth Gravel Depth

☐ New System ☐ Repair System Type: I, II, III, IV, V, VI

System Description: EXISTING

Repair System Description: Trench Covered 16" PPBAS

Maintenance Agreement Required: ☒ Yes ☐ No

☒ House/Mod. Home No. Bedrooms

☐ Mobile Home No. Bathrooms

☐ Business No. Employees

☐ Other

☐ Slab ☒ Crawl Space ☐ Basement w/plumbing ☐ Basement wo/plumbing


Water Supply:
☐ Individual
☐ Public
☒ Community

Comments:/Conditions:


Comments:/Conditions:

EXISTING SYSTEM FOR BURNOUT

INITIAL SITE SKETCH

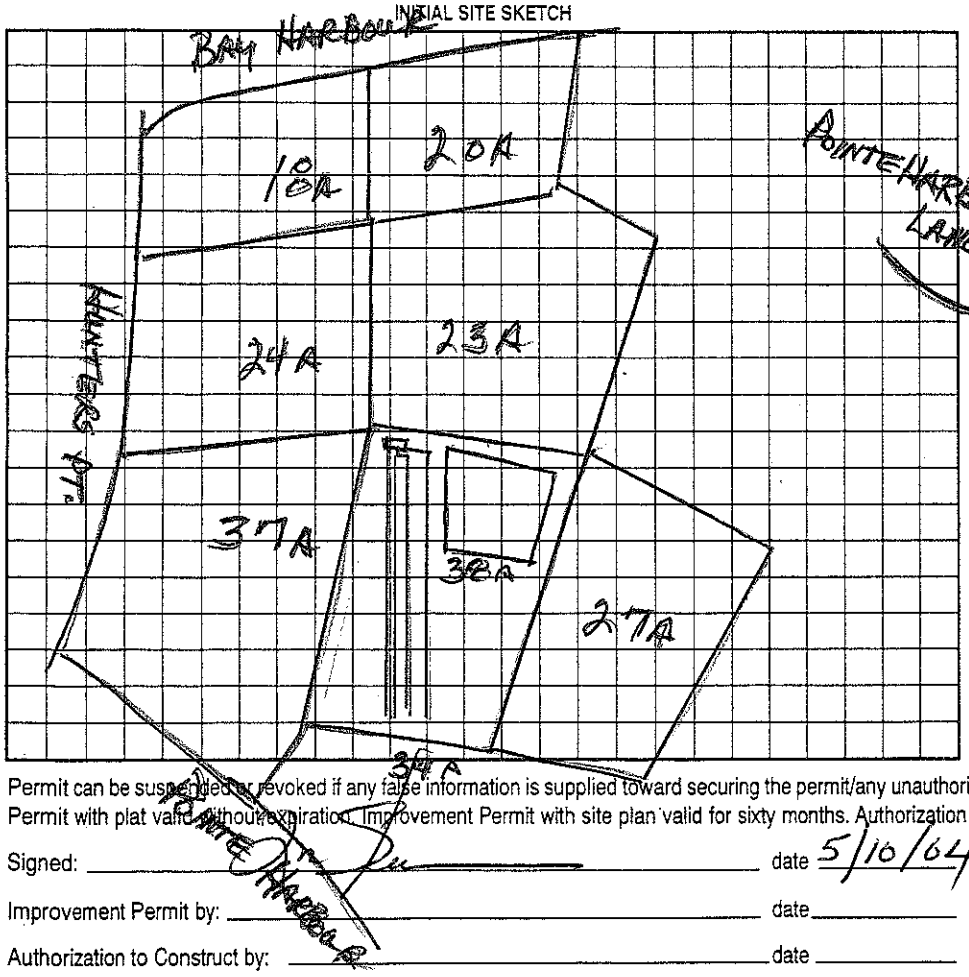

AS BUILT SKETCH

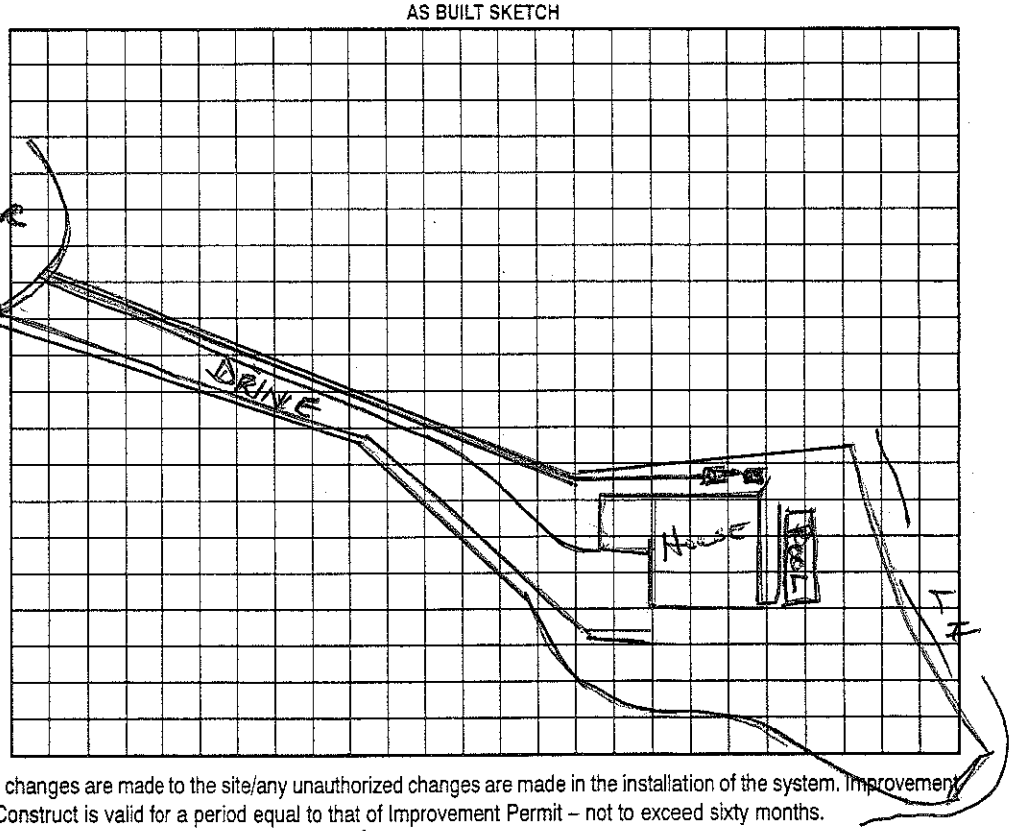

Permit can be suspended or revoked if any false information is supplied toward securing the permit/any unauthorized changes are made to the site/any unauthorized changes are made in the installation of the system. Improvement Permit with plat valid without expiration. Improvement Permit with site plan valid for sixty months. Authorization to Construct is valid for a period equal to that of Improvement Permit – not to exceed sixty months.

Signed: date 5/10/04

Improvement Permit by: date

Authorization to Construct by: date

Installed by: R+H Inc.

Operation Permit by: Wesley Sparks R.S. date 5/10/04

Existing System Inspection by: date

HEALTH DEPT. COPY: WHITE OWNER COPY (FINAL): YELLOW OWNER COPY (INITIAL): PINK

IREDELL COUNTY HEALTH DEPARTMENT

STATESVILLE 704-878-5305 — MOORESVILLE 704-664-5281

IMPROVEMENT PERMIT / AUTHORIZATION TO CONSTRUCT / OPERATION PERMIT / EXISTING SYSTEM INSPECTION

PERMIT# 120871 PIN# 4625 27 2899 DATE 5/10/04

OWNER OR CONTRACTOR Tom Stevenson Co. PHONE: Business 704-662-0105 Home

ADDRESS 816-G Brawley School Rd. Mooresville NC 28115

LOCATION 1100, TR Bay Harbour TR Hunters Pt. TL Pointe

SUBDIVISION Harbour BLOCK / SECTION 5 LOT 38-38A LOT AREA ~.87 SITE CLASS. DESIGN FLOW 480 L.T.A.R.

Septic Tank: Gallons; STB Date

Pump Tank: Gallons; PT Date

Pump Make: Model Serial No.

Nitrification Field: No Fields Square Feet EXISTING Linear Feet

No Lines Trench Width Max Trench Bottom Depth Gravel Depth

☐ New System ☐ Repair System Type: I, II, III, IV, V, VI

System Description: EXISTING

Repair System Description: Trench Drained 16" PPBAS

Maintenance Agreement Required: ☒ Yes ☐ No

☒ House/Mod. Home No. Bedrooms

☐ Mobile Home No. Bathrooms

☐ Business No. Employees

☐ Other

☐ Slab ☒ Crawl Space ☐ Basement w/plumbing ☐ Basement wo/plumbing


Water Supply: ☐ Individual ☐ Public ☒ Community

Comments:/Conditions:


Comments:/Conditions:

EXISTING SYSTEM FOR BURNOUT

INITIAL SITE SKETCH

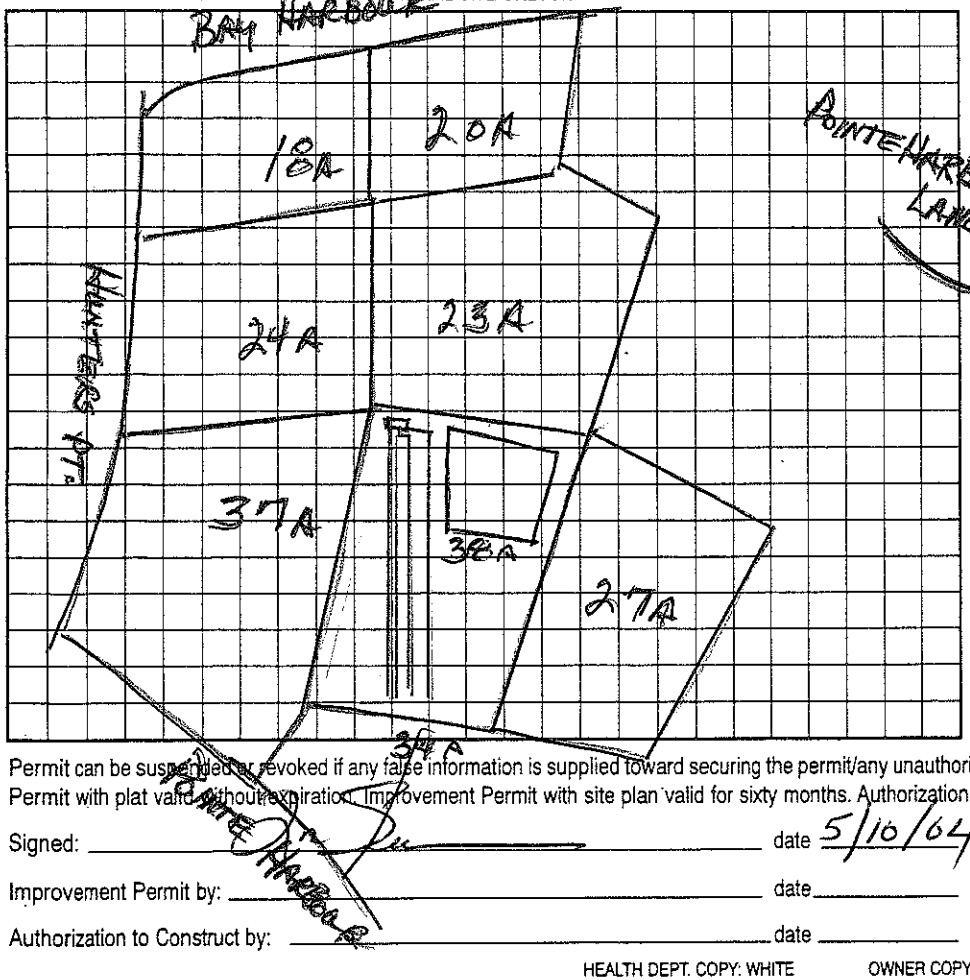

AS BUILT SKETCH

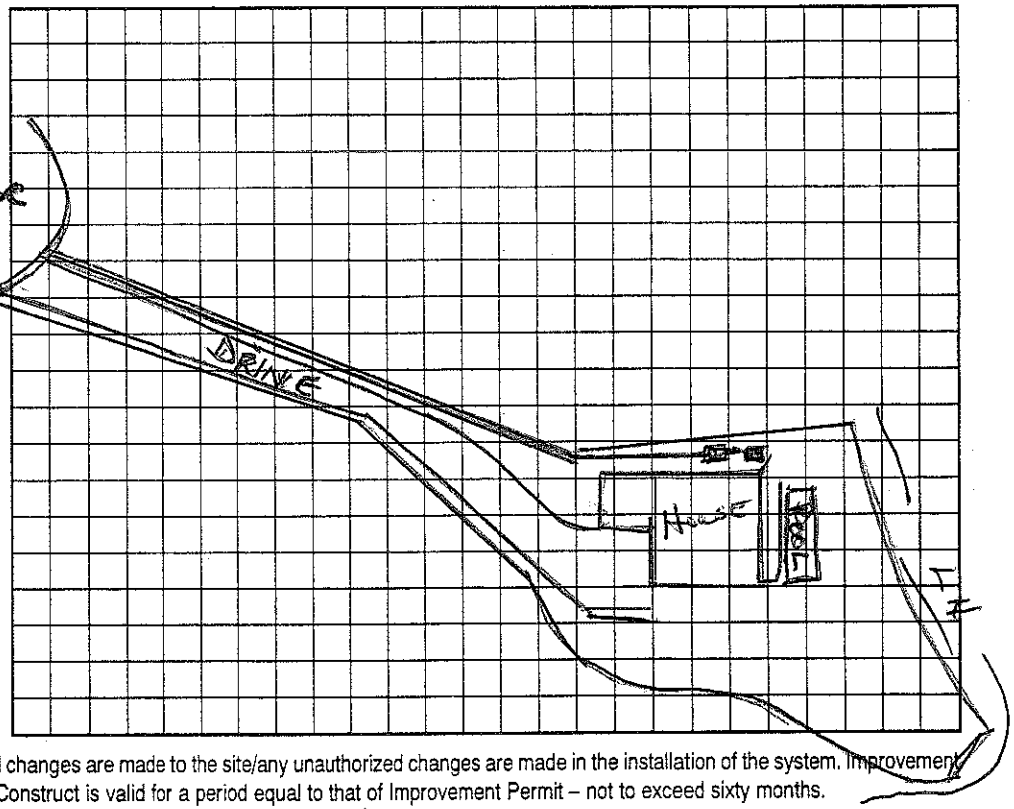

Permit can be suspended or revoked if any false information is supplied toward securing the permit/any unauthorized changes are made to the site/any unauthorized changes are made in the installation of the system. Improvement Permit with plat valid without expiration. Improvement Permit with site plan valid for sixty months. Authorization to Construct is valid for a period equal to that of Improvement Permit – not to exceed sixty months.

Signed: date 5/10/04 Installed by: R + H Inc.

Improvement Permit by: date Operation Permit by: Wesley Sparks R.S. date 5/10/04

Authorization to Construct by: date Existing System Inspection by: date

HEALTH DEPT. COPY: WHITE OWNER COPY (FINAL): YELLOW OWNER COPY (INITIAL): PINK