IREDELL COUNTY HEALTH DEPARTMENT

Const. Auth. Caleb Ebert (2:00)

STATESVILLE 704-878-5305 MOORESVILLE 704-664-5281

IMPROVEMENT PERMIT / ~~CERTIFICATE OF COMPLETION~~ / OPERATION PERMIT / EXISTING SYSTEM INSPECT

PROPERTY DESCRIPTION NO. 24381 DATE Sept 9 '96 TAX MAP NO. part of 2CA3 Watershed: ~~Yes~~

OWNER OR CONTRACTOR ~~Covenant Homes Inc Caleb Ebert~~ PHONE: Business _____ Home _____

ADDRESS PO Box 1003 Charlotte

LOCATION Bayside Sch Rd. TR Bay Harbour TR Hunters Pt TL Pointe Harbour at end

SUBDIVISION The Harbours BLOCK / SECTION 5 LOT 38 LOT AREA ~ 20,000 ft² SITE CLASS. Spr. 1956 DESIGN FLOW 480 gpd L.T.A.R. ~.3

Septic Tank: 1000 Gallons; STB 394 Date 2-11-99

Pump Tank: 1000 Gallons; PT 27 Date 5-6-99

Pump Make: _____ Model _____ Serial No. _____

Nitrification Field: No Fields 1 Square Feet 1200 Linear Feet 400

No Lines 3 Trench Width 36" Max Trench Bottom Depth ~30" Gravel Depth NA

☑ New System ☐ Repair System Type: I, II, III, IV, V, VI

System Description: pumped-pm-chambered

Repair System Description: LP tank/Block

Maintenance Agreement Required: ☐ Yes ☑ No

☑ House/Mod. Home No. Bedrooms 4

☐ Mobile Home No. Bathrooms 4

☐ Business No. Employees _____

☐ Other _____


☐ Slab ☐ Crawl Space ☑ Basement w/plumbing ☐ Basement wo/plumbing

Water Supply: ☐ Individual ☐ Community ☑ Public


Comments:

Comments:

INITIAL SITE SKETCH

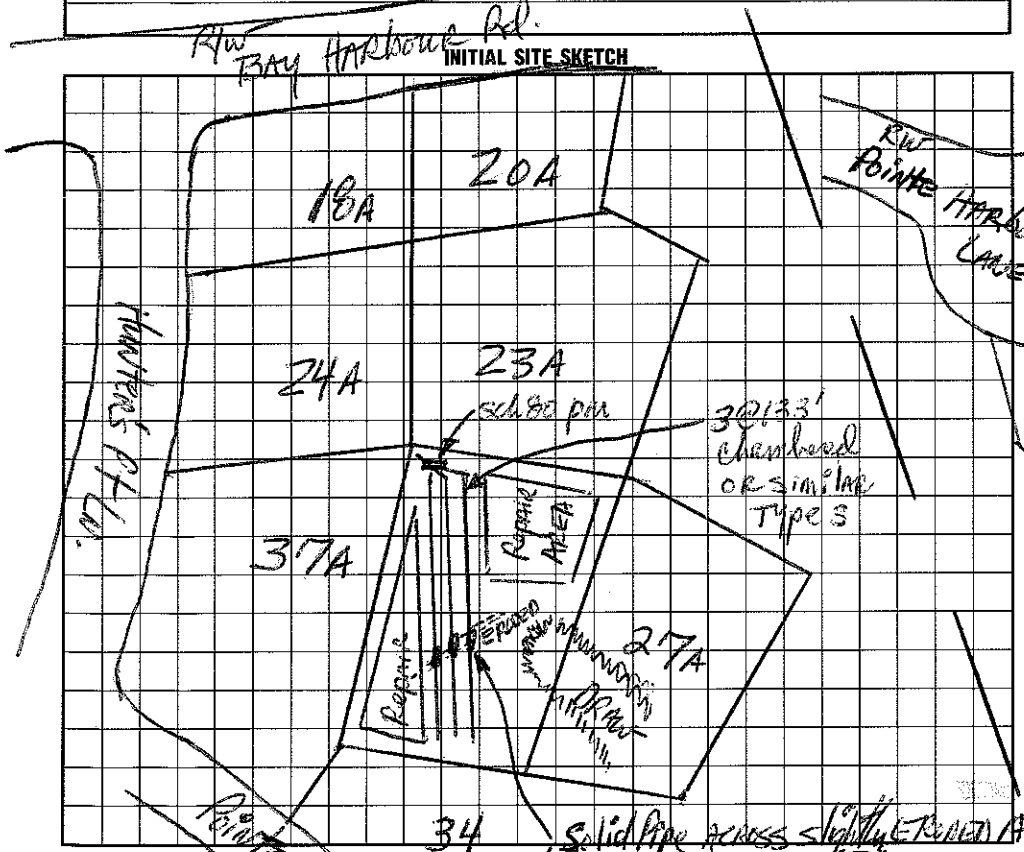

AS BUILT SKETCH

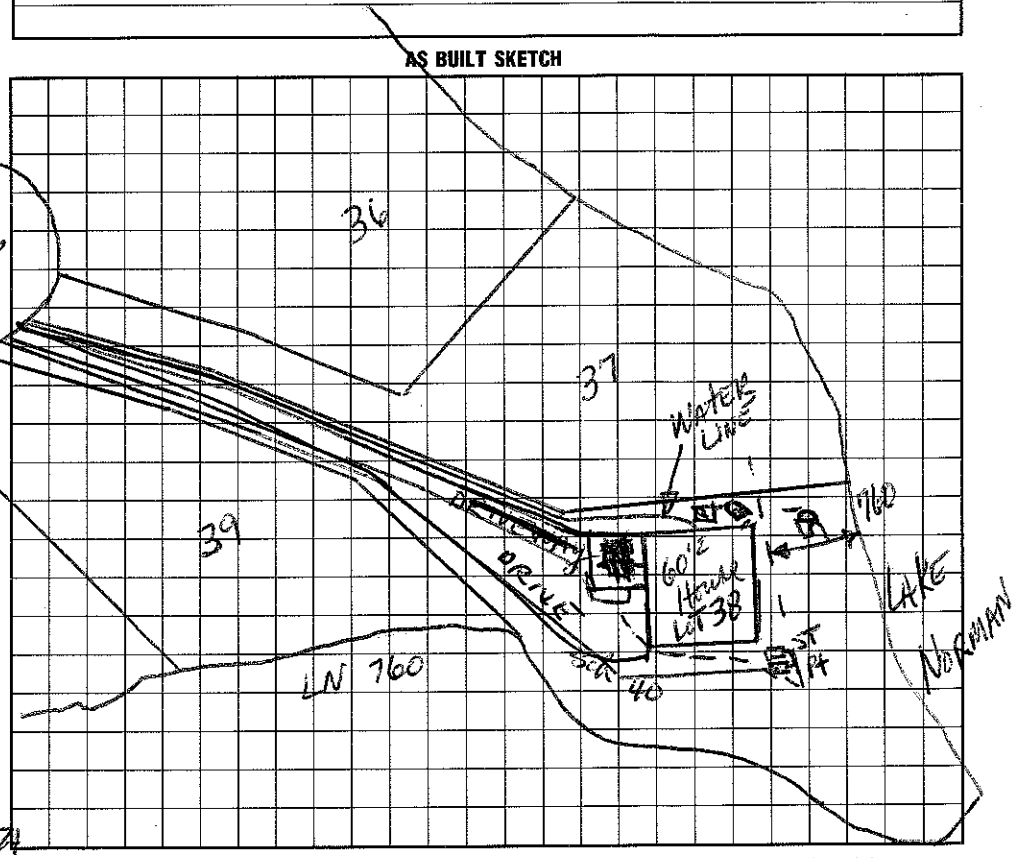

I understand that this permit can be suspended or revoked if any false information is supplied toward securing the permit/any unauthorized changes are made to the site/any unauthorized changes are made in the installation of the system.

Signed: _____ Agent

Improvement Permit by: _____ date 9-9-96

~~Existing System~~ Construction Authorization by: _____ date 7/11/97

Installed by: R & H Inc.

Certificate of Completion by: Wesley Sparks R.S. date 10/21/99

Operation Permit by: Wesley Sparks R.S. date 10/21/99

HEALTH DEPT. COPY: WHITE INSPECTION COPY (FINAL): GREEN OWNER COPY (FINAL): YELLOW INSPECTION COPY (INITIAL): PINK OWNER COPY (INITIAL): GOLD