IREDELL COUNTY HEALTH DEPARTMENT Const. Auth STATESVILLE 704-878-5305 MOORESVILLE 704-664-5281

IMPROVEMENT PERMIT / ~~CERTIFICATE OF COMPLETION~~ / OPERATION PERMIT / EXISTING SYSTEM INSPECTION

PROPERTY DESCRIPTION NO. 24380 DATE Sept 4 96 TAX MAP NO. part of 2CA3 4625 27 4838 Watershed: ☑ Yes ☐ No

OWNER OR CONTRACTOR Crescent Resources incl. Roy Bengquist PHONE: Business _____ Home _____

ADDRESS PO Box 1033 Charlotte

LOCATION Bayley Sch Rd. TR Bay Harbour Rd. TR Hunter's Pt. Ln. TR Pointe Harbour Ln. AT end

SUBDIVISION The Harbour BLOCK / SECTION 5 LOT 37 LOT AREA ≥ 20,000 ft² SITE CLASS. PS pre 1996 DESIGN FLOW 480 gpd L.T.A.R. n/a

Septic Tank: 1000 Gallons; STB 794 Date 10/97

Pump Tank: 1000 Gallons; PT 27 Date 10/97

Pump Make: GOULDS Model WS20 12 BHF Nominal No. 2HP

Nitrification Field: No Fields 1 Square Feet 1200 Linear Feet 400

No Lines 3 Trench Width 36" Max Trench Bottom Depth ~30" Gravel Depth NA

☑ New System ☐ Repair System Type: I, II, (III), IV, V, VI

System Description: pumped pressure-chambered

Repair System Description: same

Maintenance Agreement Required: ☐ Yes ☑ No

☑ House/Mod. Home ☐ Mobile Home ☐ Business ☐ Other

No. Bedrooms 4/4 No. Bathrooms 4/4 No. Employees _____


☐ Slab ☐ Crawl Space ☑ Basement w/plumbing ☐ Basement wo/plumbing

Water Supply: ☐ Individual ☐ Community ☑ Public

Comments:


Comments: 11/7/97 - CHRIS HEDRICK TOLD ME - LOT 37 WAS WHAT HE HAD QUESTIONS ON. - AWS.
11/7/97 - COPY FAXED TO 892-8373 - AWS.
5-16-46-47-2.5-27-17-9 8.1

INITIAL SITE SKETCH

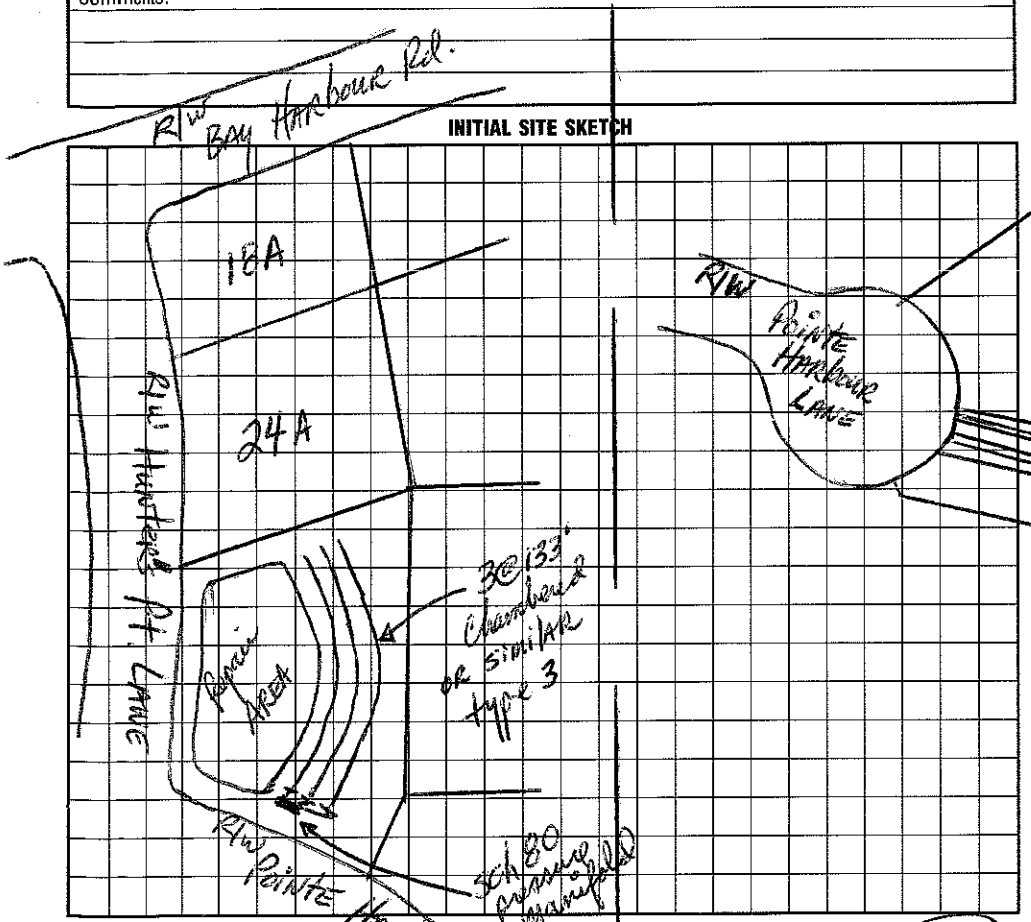

AS BUILT SKETCH 6-9 7-2.5 7-17-9


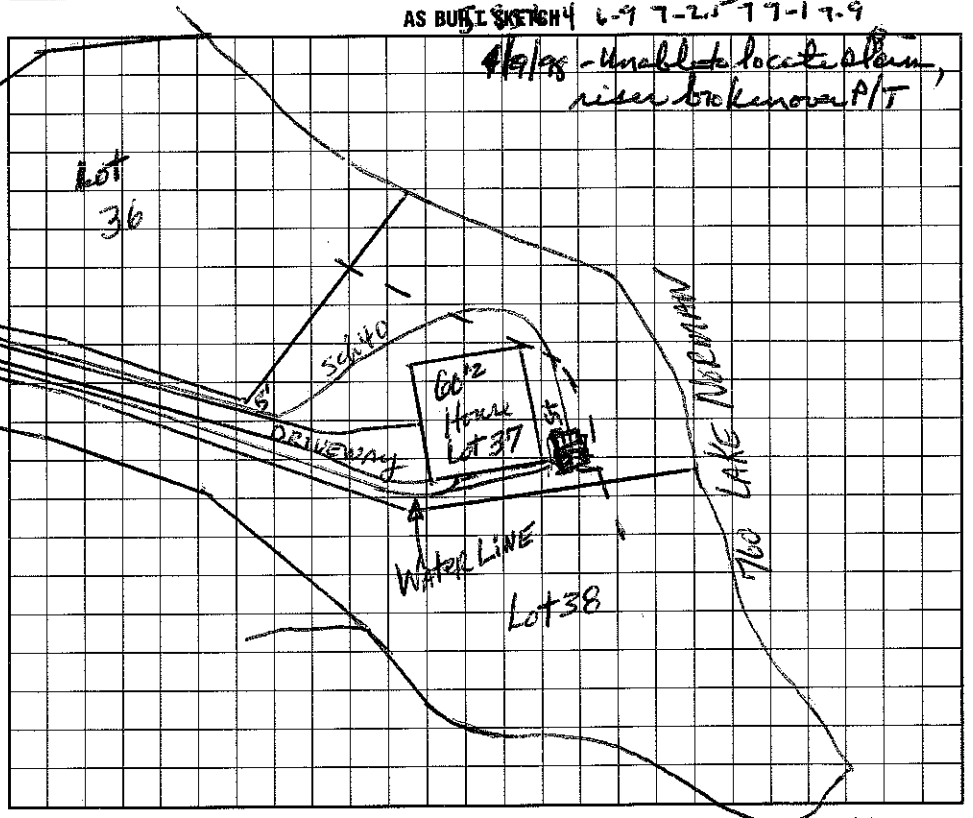

I understand that this permit can be suspended or revoked if any false information is supplied toward securing the permit/any unauthorized changes are made to the site/any unauthorized changes are made in the installation of the system.

Signed: _____ Agent

Improvement Permit by: _____, RS date 9-9-96

~~Construction Authorization~~ Existing System Inspection by: _____, RS date 5-15-97

Installed by: Chris Hedrick

Certificate of Completion by: Wesley Sparks RS date 4/15/98

Operation Permit by: Wesley Sparks RS date 4/15/98

HEALTH DEPT. COPY: WHITE INSPECTION COPY (FINAL): GREEN OWNER COPY (FINAL): YELLOW INSPECTION COPY (INITIAL): PINK OWNER COPY (INITIAL): GOLD