IREDELL COUNTY HEALTH DEPARTMENT

STATESVILLE 704-878-5305 MOORESVILLE 704-664-5281

IMPROVEMENT PERMIT / AUTHORIZATION TO CONSTRUCT / OPERATION PERMIT / EXISTING SYSTEM INSPECTION

PERMIT# 24316 PIN# ~~Ref 2C A3~~ 4625-27-5077 DATE 7/19/99

OWNER OR CONTRACTOR Stevens Construction PHONE: Business 417-4599 Home

ADDRESS 7638 Keistler-Harris Rd Stanley Fred NC 28673

LOCATION 1100 TR Bay Harbor on (R) just past Hunter Pointe Lane

SUBDIVISION HARBOUR BLOCK / SECTION 5 LOT 26 LOT AREA ~1.66AC SITE CLASS. PS DESIGN FLOW 480 L.T.A.R. .3

Septic Tank: 1000 Gallons; STB 794 Date 8/4/98
Pump Tank: 1000 Gallons; PT 27 Date 9/21/98
Pump Make: HYDROMATIC Model SHEF 100 Serial No. 3199
Nitrification Field: No Fields 1 Square Feet 810 Linear Feet 270
No Lines 4 Trench Width 36" Max Trench Bottom Depth 36" Gravel Depth SAND.


☒ New System ☐ Repair System Type: I, II, III, (IV) V, VI
System Description: Pres. Dosed - 16" PPBS
Repair System Description: SAME
Maintenance Agreement Required: ☒ Yes ☐ No

☒ House/Mod. Home No. Bedrooms 4
☐ Mobile Home No. Bathrooms 4
☐ Business No. Employees
☐ Other
☐ Slab ☐ Crawl Space ☒ Basement w/plumbing ☐ Basement wo/plumbing

Water Supply: ☐ Individual ☐ Public ☒ Community


Comments:/Conditions:

INITIAL SITE SKETCH (1" = 50')

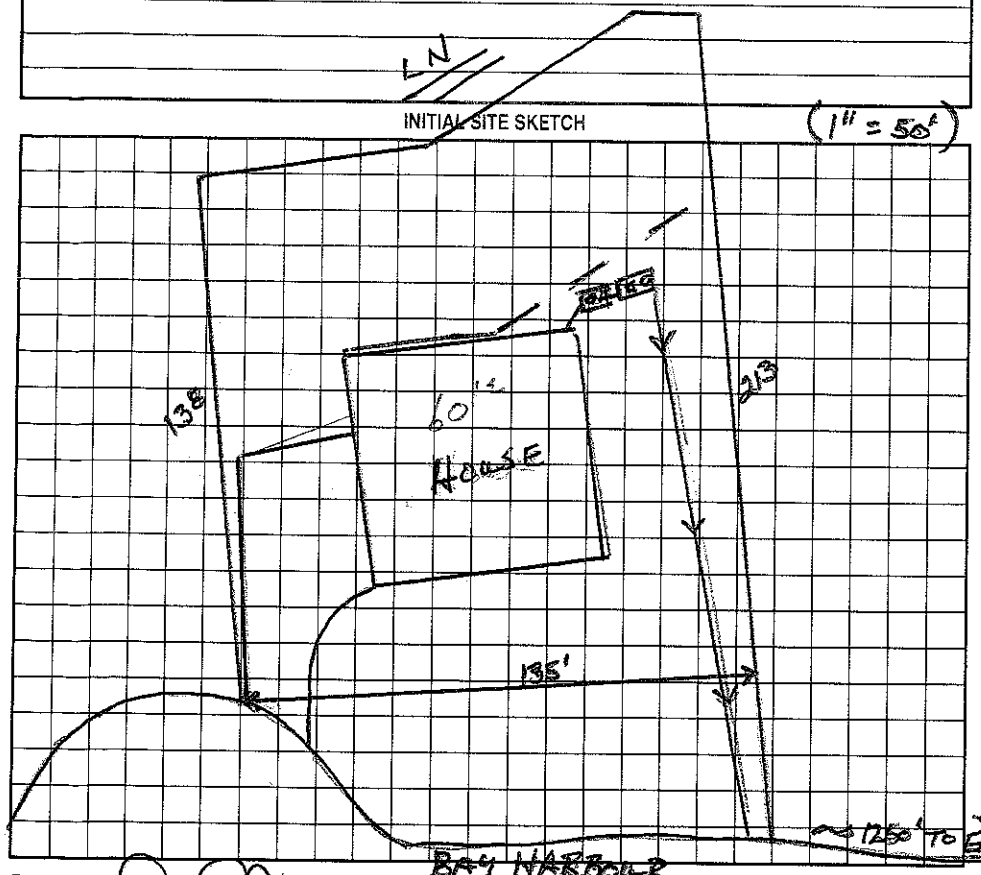

Comments:/Conditions:

INITIAL ~~SITE~~ SKETCH (1" = 50')

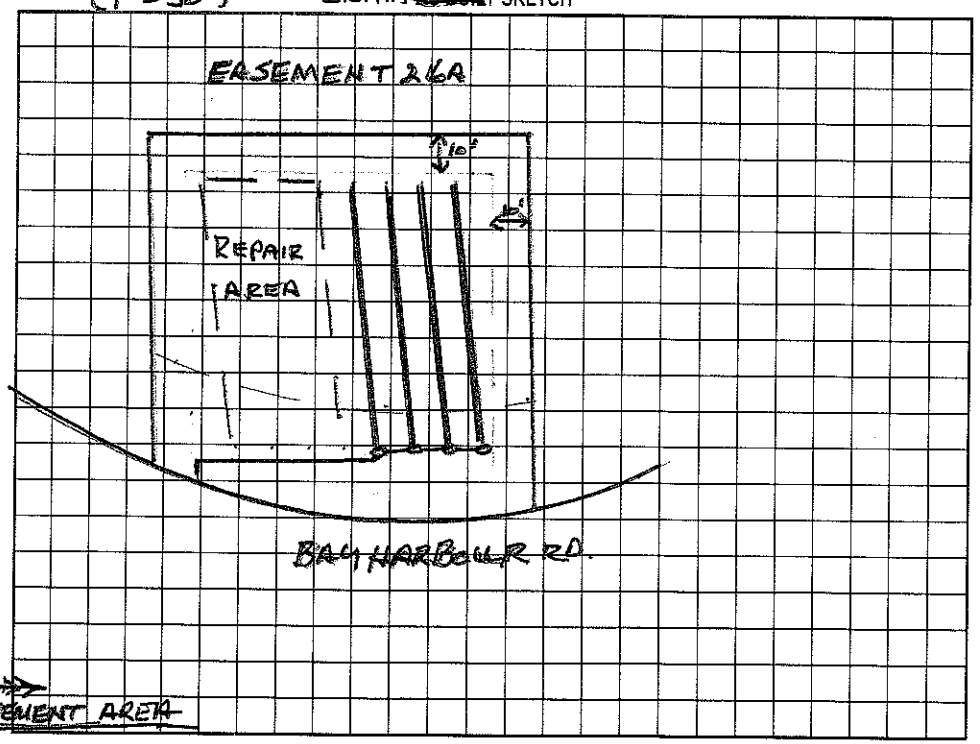

Permit can be suspended or revoked if any false information is supplied toward securing the permit/any unauthorized changes are made to the site/any unauthorized changes are made in the installation of the system. Improvement Permit with plat valid without expiration. Improvement Permit with site plan valid for sixty months. Authorization to Construct is valid for a period equal to that of Improvement Permit – not to exceed sixty months.

Signed: * D.A.R. S/C date

Improvement Permit by: Wesley Sparks RS. date 7/19/99

Authorization to Construct by: Wesley Sparks RS. date 7/19/99

Installed by: Dellinger Septic Co.

Operation Permit by: Wesley Sparks RS. date 8/6/99

Existing System Inspection by: date

HEALTH DEPT. COPY: WHITE OWNER COPY (FINAL): YELLOW OWNER COPY (INITIAL): PINK