(2.00)

IREDELL COUNTY HEALTH DEPARTMENT

STATESVILLE 704-878-5305 MOORESVILLE 704-664-5281

IMPROVEMENT PERMIT / AUTHORIZATION TO CONSTRUCT / OPERATION PERMIT / EXISTING SYSTEM INSPECTION

PERMIT# 25763 PIN# 4625 27 5995 DATE 3/16/98

OWNER OR CONTRACTOR Cliff McKee - Cliff Blake Realty PHONE: Business 892-5292 Home

ADDRESS PO Box 159, Cornelius, NC 28031

LOCATION 1100 TR Bay Harbour TR Hunters Pointe TL Pointe Harbour, on (L) at end de acc

SUBDIVISION HARBOUR BLOCK / SECTION 5 LOT 36 LOT AREA ~.79AC SITE CLASS. PS DESIGN FLOW 480 L.T.A.R. .3

Septic Tank: 1000 Gallons; STB 794 Date 3/23/98
Pump Tank: 1000 Gallons; PT 27 Date 9/2/98
Pump Make: HYDROMATIC Model SHEF 50-A1 Serial No. 7/14/98
Nitrification Field: No Fields 1 Square Feet 888 Linear Feet 266
No Lines 5 Trench Width 36" Max Trench Bottom Depth 36"

[X] New System [ ] Repair System Type: I, II, III, (IV) V, VI
System Description: Pressure Dosed - 16" PPBS
Repair System Description: SAME
Maintenance Agreement Required: [X] Yes [ ] No
Gravel Depth SAND.


[X] House/Mod. Home No. Bedrooms 4
[ ] Mobile Home No. Bathrooms 3
[ ] Business No. Employees
[ ] Other
[ ] Slab [ ] Crawl Space [X] Basement w/plumbing [ ] Basement wo/plumbing

Water Supply: [ ] Individual [ ] Public [X] Community


Comments:/Conditions:
50% reduction granted for PPBS use

Comments:/Conditions: 9" = 180 Gal DESE 6 6 180-
4
264

INITIAL SITE SKETCH

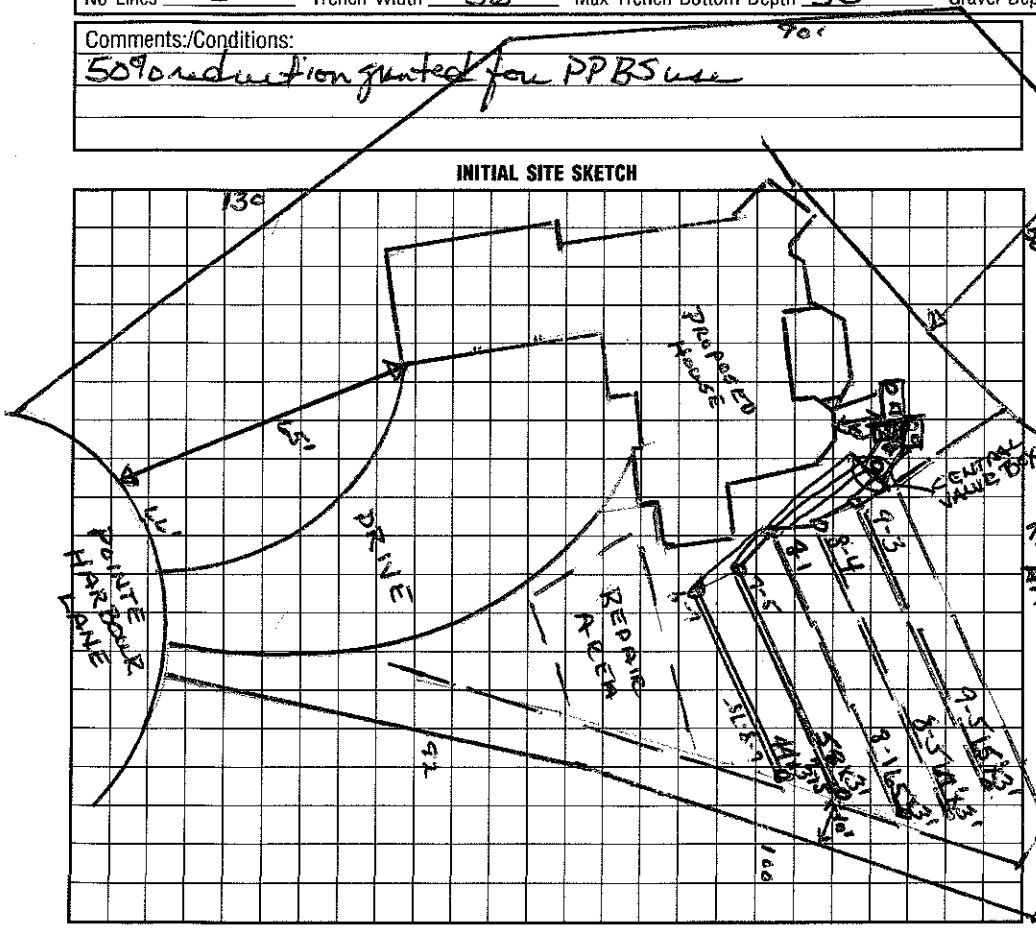

AS BUILT SKETCH

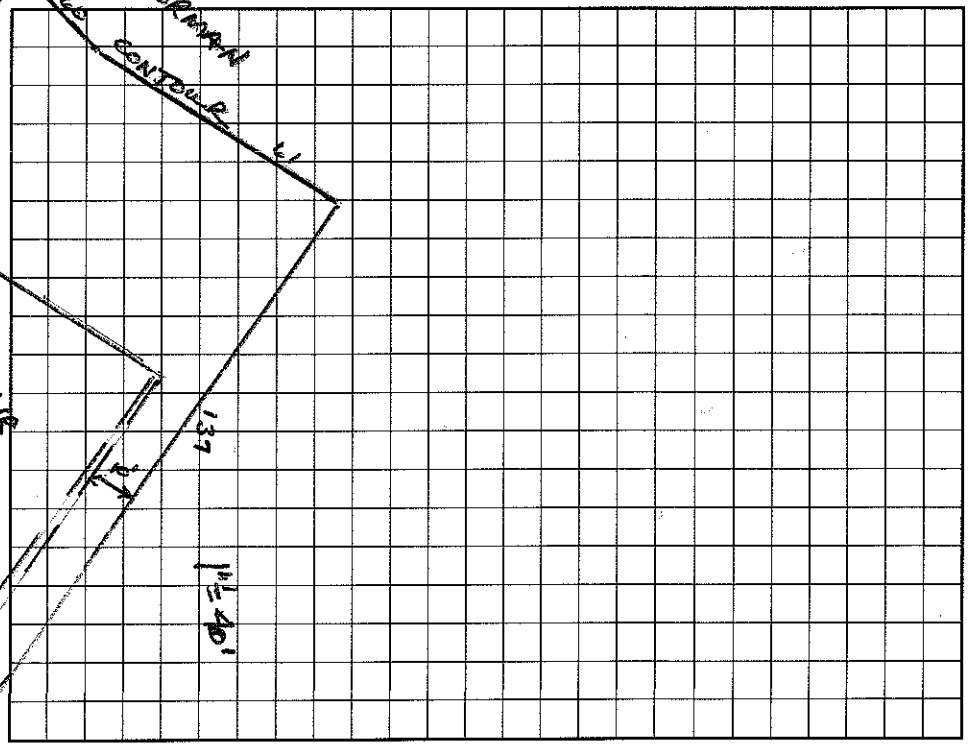

I understand that this permit can be suspended or revoked if any false information is supplied toward securing the permit/any unauthorized changes are made to the site/any unauthorized changes are made in the installation of the system. Improvement Permit with plat valid without expiration. Improvement Permit with site plan valid for sixty months. Authorization to Construct is valid for a period equal to that of Improvement Permit – not to exceed sixty months.

Signed: Adrianne S. McKee date 3/17/98

Improvement Permit by: Wesley Sparks R.S. date 3/16/98

Authorization to Construct by: Wesley Sparks R.S. date 3/16/98

Installed by: Orbison Const. Co.

Operation Permit by: Wesley Sparks R.S. date 12/15/98

Existing System Inspection by: date

HEALTH DEPT. COPY: WHITE INSPECTION COPY (FINAL): GREEN OWNER COPY (FINAL): YELLOW INSPECTION COPY (INITIAL): PINK OWNER COPY (INITIAL): GOLD