900.00

IREDELL COUNTY HEALTH DEPARTMENT

STATESVILLE 704-878-5305 MOORESVILLE 704-664-5281

IMPROVEMENT PERMIT / AUTHORIZATION TO CONSTRUCT / OPERATION PERMIT / EXISTING SYSTEM INSPECTION

PERMIT# N/A PIN# 4625 27 6166 DATE 2/2/06

OWNER OR APPLICANT Kevin Hoffman PHONE: Business 828-817-0962 Home

ADDRESS 484 Bay Harbour Rd. Mooresville, NC. 28117

LOCATION 1100 TR Bay Harbour near end on (R)

SUBDIVISION HARBOUR BLOCK / SECTION 5 LOT 27-27A LOT AREA .57 SITE CLASS. PS DESIGN FLOW 480 L.T.A.R. .3

Septic Tank: EXIST Gallons; STB Date

Pump Tank: EXIST Gallons; PT Date

Pump Make: Model Serial No.

Nitrification Field: No Fields Square Feet 1200 Linear Feet 400

No Lines 3@133' Trench Width 3' Max Trench Bottom Depth 3'

☐ New System ☒ Repair ☐ Expansion System Type: I II (III) IV V VI

System Description:

Repair System Description: PM → 25% Reduced

Maintenance Agreement Required: ☒ Yes ☐ No

☒ House/Mod. Home No. Bedrooms 4

☐ Mobile Home No. Persons

☐ Business No. Employees

☐ Other


Water Supply: ☐ Individual ☐ Public ☒ Community

Gravel Depth N/A ☐ Gravity ☒ Pressure ☐ Slab ☐ Crawl Space ☒ Basement w/plumbing ☐ Basement wo/plumbing


Comments:/Conditions:

Comments:/Conditions: EZ Flow installed Pump approx. 2 ft. from garage

INITIAL SITE SKETCH

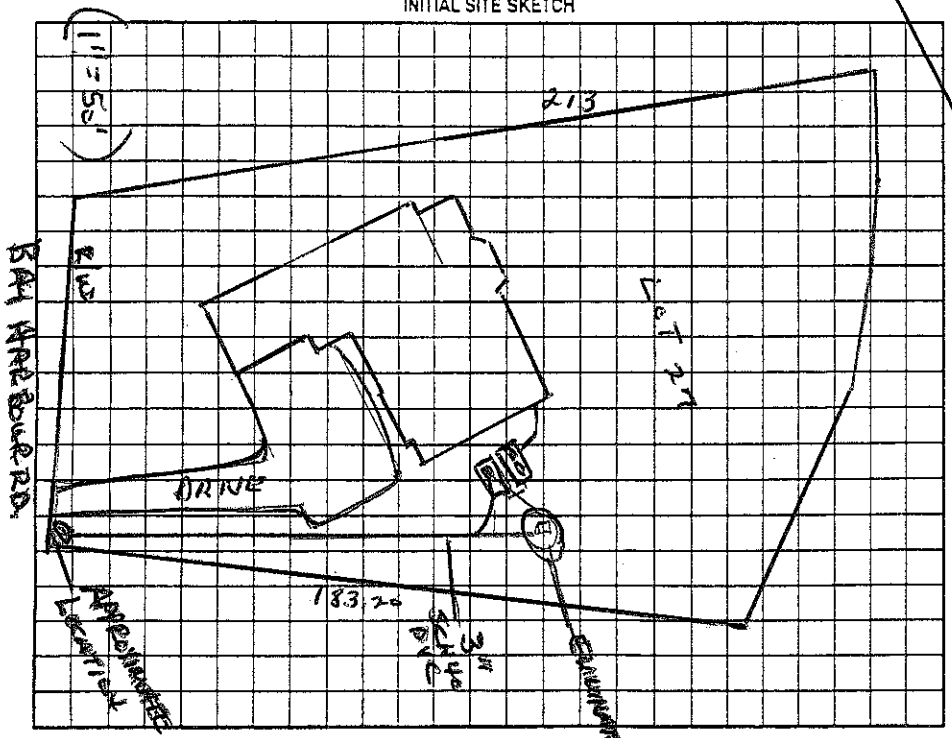

AS BUILT SKETCH

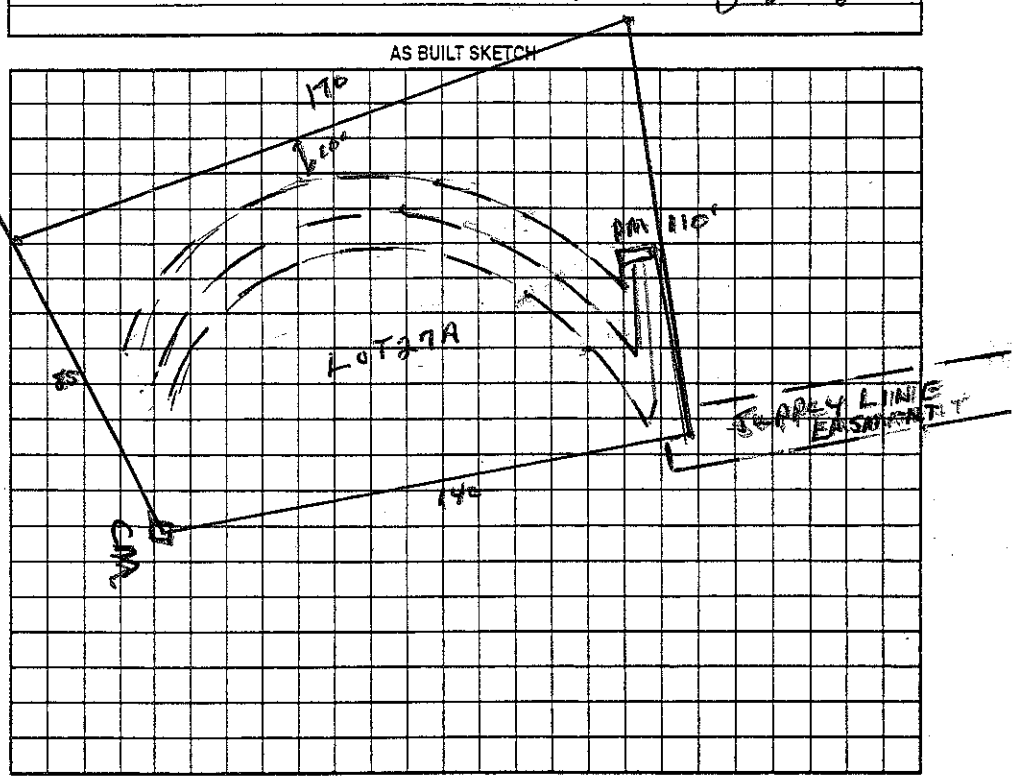

Permit can be suspended or revoked if any false information is supplied toward securing the permit/any unauthorized changes are made to the site/any unauthorized changes are made in the installation of the system. Improvement Permit with plat valid without expiration ☐ Improvement Permit with site plan valid for sixty months ☐ Authorization to Construct is valid for a period equal to that of Improvement Permit – not to exceed sixty months.

Signed: [signature] date 2/8/06

Improvement Permit by: Wesley Sparks R.S. date 2/2/06

Authorization to Construct by: Wesley Sparks R.S. date 2/2/06

Installed by: R+H

Operation Permit by: Wesley Sparks R.S. date 3/2/06

Existing System Inspection by: date

HEALTH DEPT. COPY: WHITE OWNER COPY (FINAL): YELLOW OWNER COPY (INITIAL): PINK