IREDELL COUNTY HEALTH DEPARTMENT

AUTHORIZATION TO CONSTRUCT (660-6638)

STATESVILLE 704-878-5305 MOORESVILLE 704-664-5281

IMPROVEMENT PERMIT / ~~CERTIFICATE OF COMPLETION~~ / OPERATION PERMIT / EXISTING SYSTEM INSPECTION

PROPERTY DESCRIPTION NO. 24377 DATE 12/23/96 TAX MAP NO. ~~2CA3 pt of~~ 4625-27-6166 Watershed: ☑ YES ☐ No

OWNER OR CONTRACTOR CLEMENT RESOURCES INC PHONE: Business _____ Home 660-6638 - TOM STEVENSON

ADDRESS PO BOX 1002 CHARLOTTE

LOCATION BRAWLEY SCHOOL - TR BAY HARBOUR - ON FT MEAD END

SUBDIVISION HARBOUR BLOCK / SECTION 5 LOT 27 LOT AREA 39074 Ft² SITE CLASS. PS DESIGN FLOW 660 GPD L.T.A.R. .30 PD/FT²

Septic Tank: 1000 Gallons; STB 794 Date 2/4/98

Pump Tank: 1000 Gallons; PT 27 Date 2/4/98

Pump Make: Oulds Model WE05511H Serial No. LS730781

Nitrification Field: No Fields 2 Square Feet 810 Linear Feet 270

No Lines 4 Trench Width 24" Max Trench Bottom Depth 36" Gravel Depth N/A

☑ New System ☐ Repair System Type: I, II, III, (IV), V, VI

System Description: PUMP PANEL

Repair System Description: OFF-SITE - PANEL

Maintenance Agreement Required: ☑ Yes ☐ No SEE ATTACHED

☑ House/Mod. Home No. Bedrooms 4

☐ Mobile Home No. Bathrooms 4

☐ Business No. Employees ____

☐ Other ____


☐ Slab ☑ Crawl Space ☐ Basement w/plumbing ☐ Basement wo/plumbing

Water Supply: ☐ Individual ☑ Community ☐ Public

Comments:

Comments: upper drainfield mulched + sprinkled 7/22/98

INITIAL SITE SKETCH

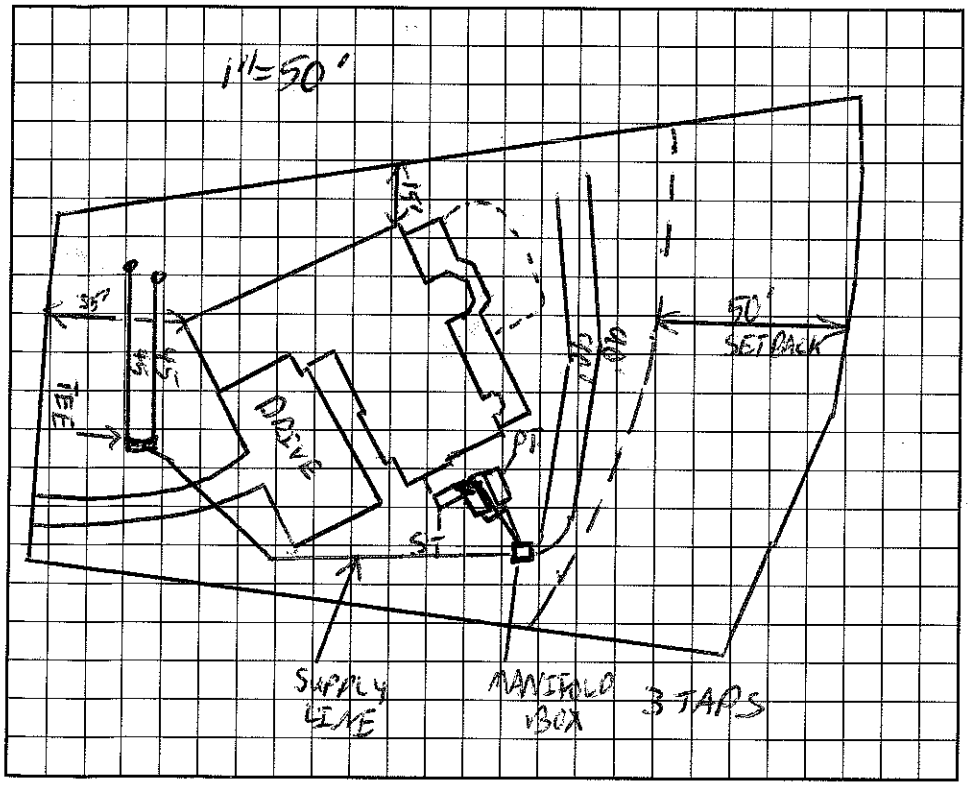

AS BUILT SKETCH

I understand that this permit can be suspended or revoked if any false information is supplied toward securing the permit/any unauthorized changes are made to the site/any unauthorized changes are made in the installation of the system.

Signed: Tony Jones CPSS 12-30-96

Improvement Permit by: [signature] date 12/23/96

Existing System Inspection by: [signature] date 12/23/96

Installed by: R+H CHRIS HEDRICK

Certificate of Completion by: Wesley Sparks RS. date 7/22/98

Operation Permit by: Wesley Sparks RS date 7/22/98

PD CONSIDERATION FOR LOT 24776 N

HEALTH DEPT. COPY: WHITE INSPECTION COPY (FINAL): GREEN OWNER COPY (FINAL): YELLOW INSPECTION COPY (INITIAL): PINK OWNER COPY (INITIAL): GOLD