IREDELL COUNTY HEALTH DEPARTMENT

STATESVILLE 704-878-5305 MOORESVILLE 704-664-5281

IMPROVEMENT PERMIT / AUTHORIZATION TO CONSTRUCT / OPERATION PERMIT / EXISTING SYSTEM INSPECTION

PERMIT# 115737 PIN# 4625-27-8232

OWNER OR APPLICANT Rick Howell (VAN SAINT) PHONE: Business _____ DATE 7/2/07

ADDRESS 3544 Amity Hill Rd Statesville Home _____

LOCATION B.S.R. Dyer Ray Harbour, near end on Right easement on right just before lot

SUBDIVISION The Harbour BLOCK / SECTION 5 LOT 28/2 SHOT AREA .69 Acre SITE CLASS. PSJ DESIGN FLOW 600 L.T.A.R. .3/SFG on-site

Septic Tank: 1500 Gallons; STB 1011 Date 2/24/06

Pump Tank: 1500 Gallons; PT 99 Date 3/20/07

Pump Make: Gulds Model# WE102HU Serial No# H07565912

Nitrification Field: No Fields 1 Square Feet 1500 Linear Feet 500

No Lines 6@83' Trench Width 36" Max Trench Bottom Depth 36

☒ New System ☐ Repair ☐ Expansion System Type: I II (III) IV V VI

System Description: Pump → 25% Reduction/Off

Repair System Description: LP Panel (on-site)

Maintenance Agreement Required: ☐ Yes ☒ No

Gravel Depth — ☐ Gravity ☒ Pressure ☐ Slab ☐ Crawl Space ☒ Basement w/plumbing ☐ Basement wo/plumbing

☒ House/Mod. Home ☐ Mobile Home ☐ Business ☐ Other


No. Bedrooms 5 No. Persons ____ No. Employees ____

Water Supply: ☐ Individual ☐ Public ☒ Community


Comments:/Conditions: Grade out any burms/low areas & install lines on contour. Manifold box and supply lines can be within 5 feet from prop. line, Drain lines must be 10' off P.L.

Comments:/Conditions: Tanks.

INITIAL SITE SKETCH

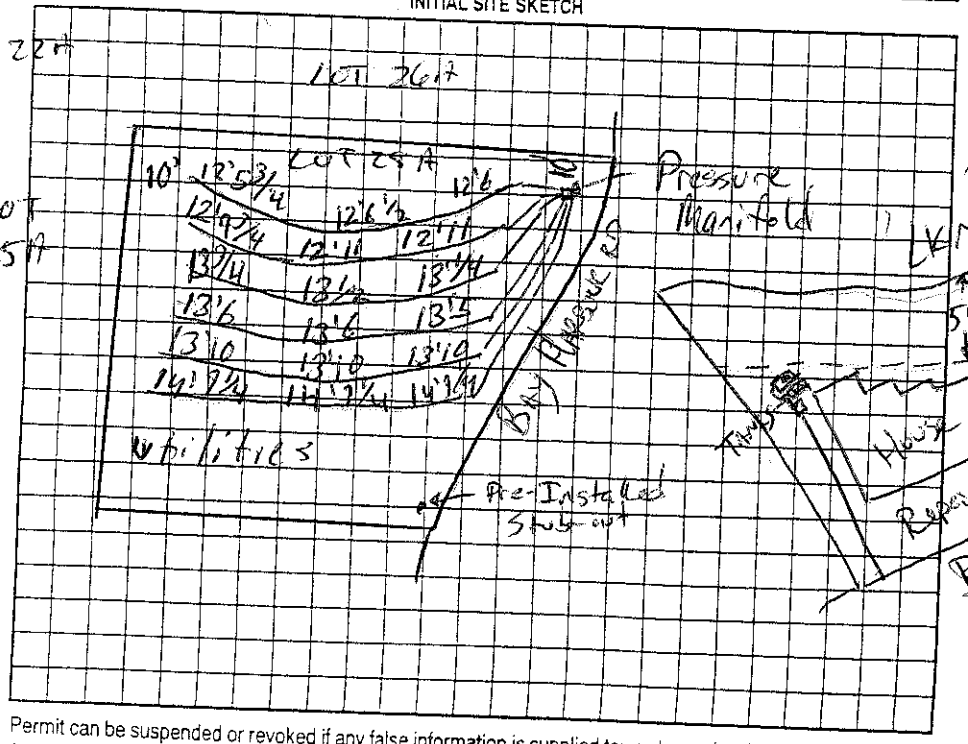

AS BUILT SKETCH

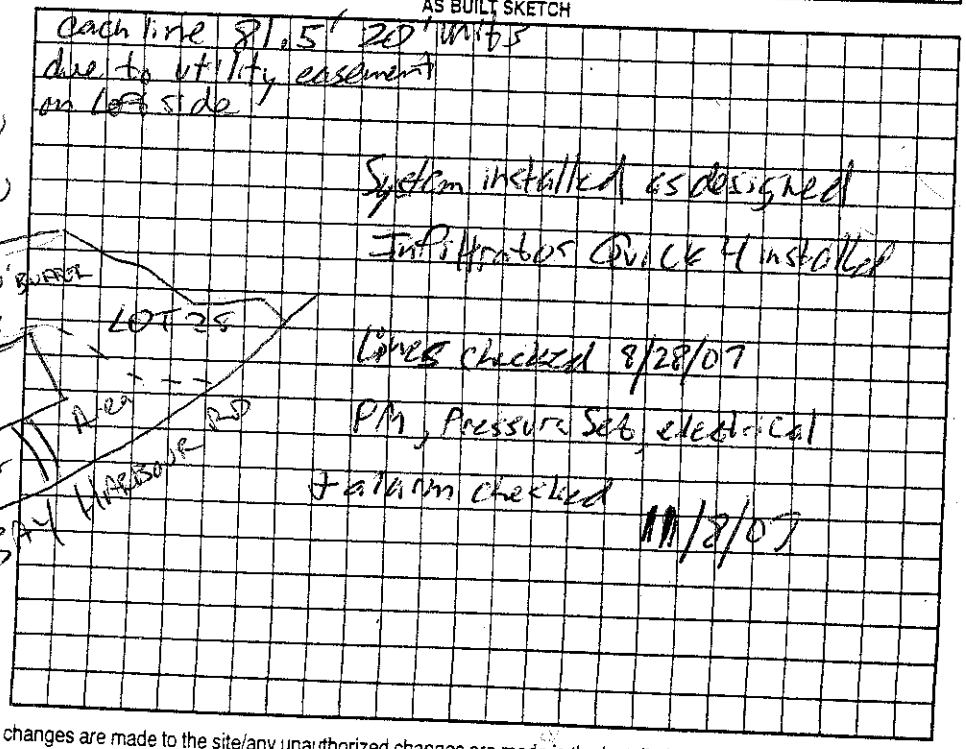

Permit can be suspended or revoked if any false information is supplied toward securing the permit/any unauthorized changes are made to the site/any unauthorized changes are made in the installation of the system. Improvement Authorization to Construct is valid for a period equal to that of Improvement Permit – not to exceed sixty months.

Permit with plat valid without expiration ☐ Improvement Permit with site plan valid for sixty months ☒

Signed: _____ date 7-5-07

Improvement Permit by: _____ date 7/3/07

Authorization to Construct by: _____ date 7/3/07

Installed by: Steve Jordan. Put incorrect date on Authorization to Construct

Operation Permit by: _____ date 11/8/07

Existing System Inspection by: _____ date _____

HEALTH DEPT. COPY: WHITE OWNER COPY (FINAL): YELLOW OWNER COPY (INITIAL): PINK