IREDELL COUNTY HEALTH DEPARTMENT

Const Auth. STATESVILLE 704-878-5305 MOORESVILLE 704-664-5281

IMPROVEMENT PERMIT / ~~CERTIFICATE OF COMPLETION~~ / OPERATION PERMIT / EXISTING SYSTEM INSPECTION

PROPERTY DESCRIPTION NO. 24386 DATE Sept 9, '96 TAX MAP NO. pt of 2643 4625-28-1574 Watershed: ☑ Yes ☐ No

OWNER OR CONTRACTOR Crescent Resources Inc. GEORGE Goodson PHONE: Business _____ Home _____

ADDRESS PO Box 223, Charlotte

LOCATION Bayley Sch Rd. TR Bay Harbour TR Hunter's Pt at end

SUBDIVISION The Harbour BLOCK / SECTION 5 LOT 45 LOT AREA > 20,000 ft² SITE CLASS. PS on 1936 DESIGN FLOW 480gpd L.T.A.R. ~.3

Septic Tank: 1000 Gallons; STB 794 Date 12/13/98
Pump Tank: 1000 Gallons; PT 27 Date 12/09/98
Pump Make: MYERS Model ME-50 Serial No. 1 898
Nitrification Field: No Fields 1 Square Feet 560 Linear Feet 280
No Lines 4@70' Trench Width 24" Max Trench Bottom Depth ~30" Gravel Depth NA

☑ New System ☐ Repair System Type: I, II, III, IV, V, VI
System Description: LP Panel Block
Repair System Description: Same
Maintenance Agreement Required: ☑ Yes ☐ No


☑ House/Mod. Home No. Bedrooms 4
☐ Mobile Home No. Bathrooms 4
☐ Business No. Employees ____
☐ Other ____
☐ Slab ☐ Crawl Space ☑ Basement w/plumbing ☐ Basement wo/plumbing

Water Supply:
☐ Individual
☐ Community
☑ Public


Comments:

Comments:

INITIAL SITE SKETCH

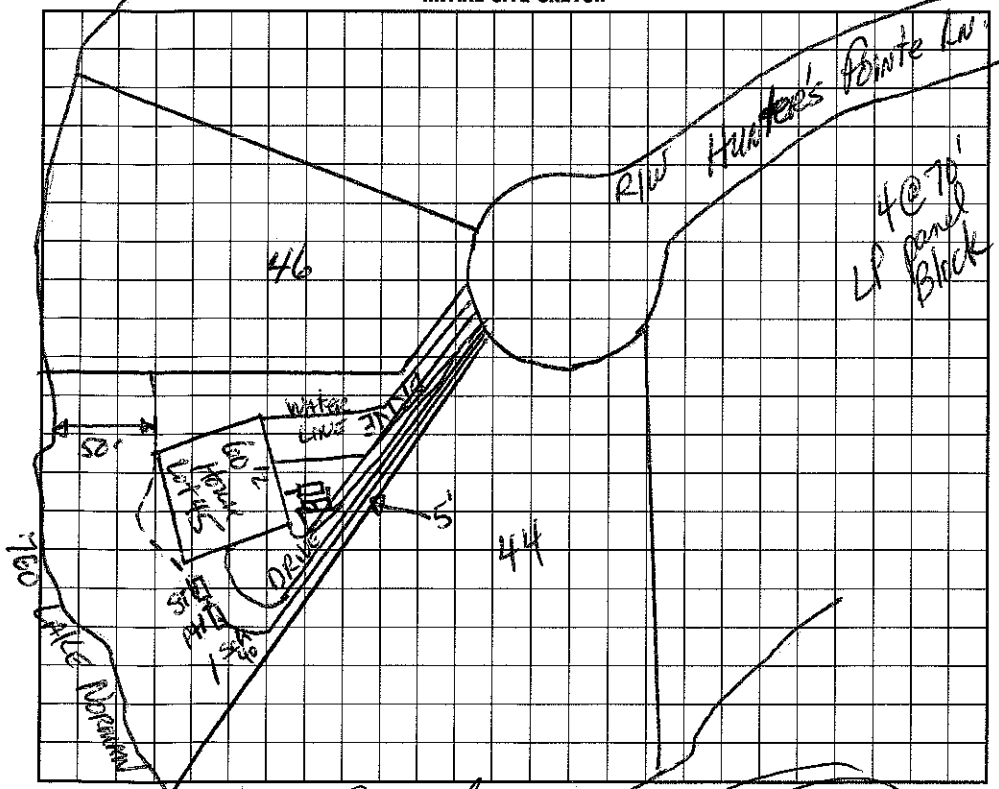

AS BUILT SKETCH

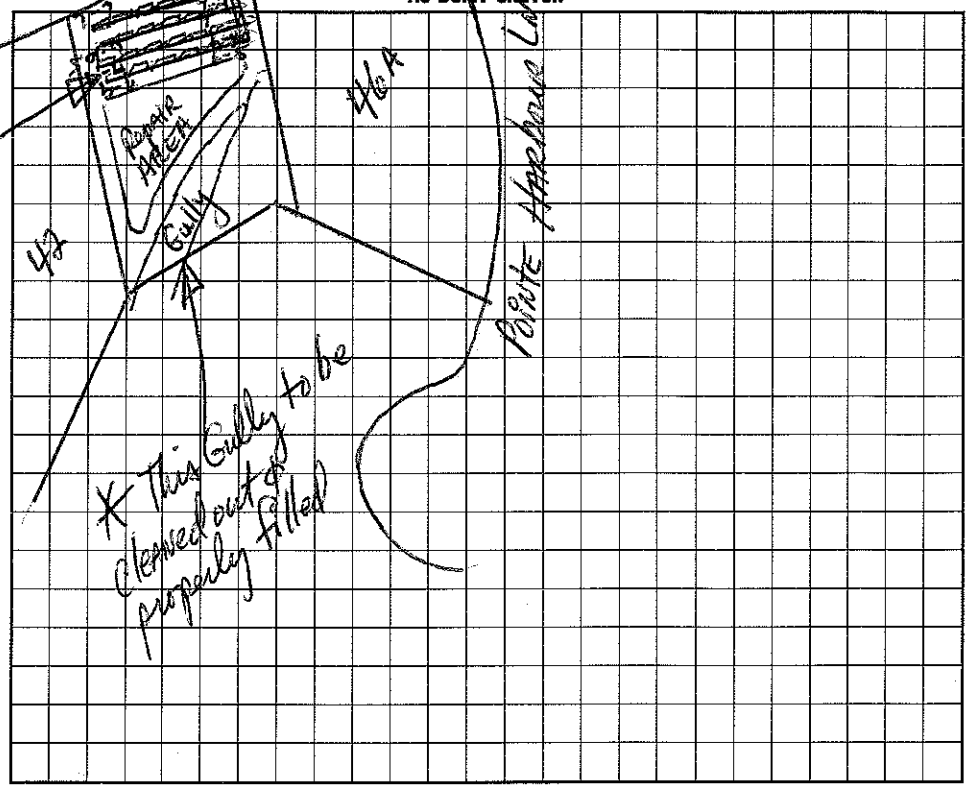

I understand that this permit can be suspended or revoked if any false information is supplied toward securing the permit/any unauthorized changes are made to the site/any unauthorized changes are made in the installation of the system.

Signed: _____ Agent

Improvement Permit by: _____ RS date 9-9-96

~~Construction/Existing System Inspection~~ by: _____ RS date 3/24/98

Installed by: H+R Inc.

Certificate of Completion by: _____ RS date 1/25/2001

Operation Permit by: _____ RS date 1/25/2001

Author: ZA Heath DEPT. COPY: WHITE INSPECTION COPY (FINAL): GREEN OWNER COPY (FINAL): YELLOW INSPECTION COPY (INITIAL): PINK OWNER COPY (INITIAL): GOLD